

FILED

*[Signature]*

JUL 14 1986

OREGON CORNER RESTORATION FORM

Section 36 Township 27S Range 8W

County Douglas Date June 1986

COUNTY SURVEYOR  
DOUGLAS COUNTY, ORE

Corner Designation

West 1/4 corner

- Condition Report Only
- Not Found
- Renewed
- Unrecorded
- Surveyed In
- Referenced Out

Previous Renewals/Surveys, etc. \_\_\_\_\_

Monument(s) & Accessories Found: (Condition and Source)

12" D. Fir bears N49°E; 13<sup>31</sup> ft. (record 12<sup>1</sup> ft.) scribe partially visible. (1979)

15" D. Fir bears S89°W; 5<sup>2</sup> ft. scribe partially visible (1979)

Monument Detail

1 1/2" Threaded I.P. with a 2" B.C., extends 4" above ground. set by L.S. 618.

Sketch

T27S R8W  
1/4  
S35 • S36  
1979


Monument Set (Procedures and Description)

New Accessories

Location & Comments

Compass Declination 19°E  
 Firm/Agency Champion International  
 Address P.O. BOX 1328  
Roseburg, OR.  
 Party Chief Lynn Sibley  
 Notes Lynn Sibley  
 Witness Dean Turner

Surveyor's Seal

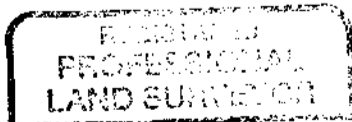

*Ronald G. Geisler*  
OREGON  
JULY 19, 1982  
RONALD G. GEISLER  
1981