

FILED

OREGON CORNER RESTORATION FORM

JUL 24 1986

Section 2 Township 30S Range 1W

County Douglas Date 7-16-86

COUNTY SURVEYOR  
DOUGLAS COUNTY, ORE.

Corner Designation

- Condition Report Only
- Not Found
- Renewed
- Unrecorded
- Surveyed In
- Referenced Out

Previous Renewals/Surveys, etc.

Monument(s) & Accessories Found: (Condition and Source)


11" FIR (stump) Bear's S01°W - 142 FT Scribing Visible (1967)  
15" D.FIR Bear's N89°W - 187 FT Scribing Visible (1985)  
19" D.FIR Bear's N50°W - 143 FT Scribing Partially Visible (1978)

SLASH BURN KILLED B.T.'S - BUT STILL SOLID.

Monument Detail

Sketch

2 1/2" B.C. on a 2 1/2" I.P.  
extends 6" Above grd.  
ALSO Found: 2 1/2" Alum CAP  
on a 1" I.P. Set By RE-4287  
(1967) S 14 1/2° W (Rec. 13° 29' 15" E)  
520 FT (Rec. 513 FT)

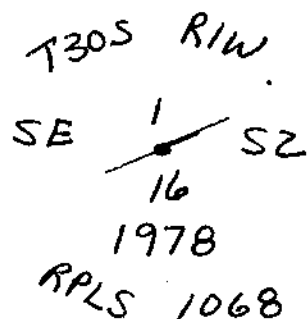


Monument Set (Procedures and Description)

New Accessories

Location & Comments

Surveyor's Seal

Compass Declination 19° E  
 Firm/Agency CHAMPION  
International  
 Address P.O. Box 1328  
Roseburg OR  
 Party Chief Dean Turner  
 Notes Lynn Sibley  
 Witness \_\_\_\_\_

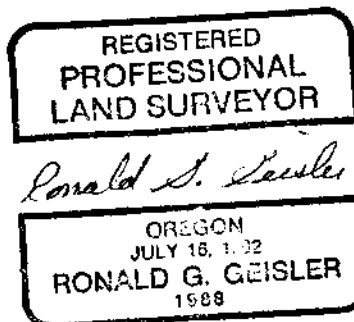

C.S. File No. 63/34-41