

FILED

OREGON CORNER RESTORATION FORM

JUL 24 1986

Section 2 Township 30S Range 1W

COUNTY SURVEYOR  
DOUGLAS COUNTY, ORE.

County Douglas Date 7-18-86

Corner Designation

C.S. 1/16

- Condition Report Only
- Not Found
- Renewed
- Unrecorded
- Surveyed In
- Referenced Out

Previous Renewals/Surveys, etc. \_\_\_\_\_


Monument(s) & Accessories Found: (Condition and Source)

- 7" D. FIR Bear's S37°W - 27<sup>8</sup> FT - Scribing Visible (1985)
- 18" D. FIR (STUMP) Bear's N65°W - 14<sup>2</sup> FT Healed Face (1967)
- 18" Cedar (now windfall) Bear's N52°E - 9<sup>2</sup> FT to Root Hole Healed FACE (1967)
- 11" Cedar bear's N68<sup>1</sup>/<sub>2</sub>°E - 30<sup>2</sup> FT Scribing Visible (1985)

Monument Detail

Sketch

2 1/2" B.C. on a 2 1/2" I.P.  
 , extends 10" Above grd  
 ALSO Found  
 2 1/2" Alum CAP on a 1" I.P.  
 Set by RE-4287 (1967)  
 Bear's S00°38'E - 2<sup>2</sup> FT  
 From B.C.

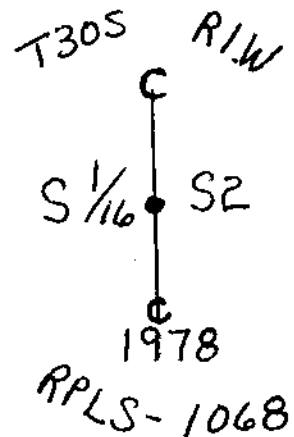


Monument Set (Procedures and Description)

New Accessories

Location & Comments

Surveyor's Seal

Compass Declination 19°E  
 Firm/Agency CHAMPION International  
 Address P.O. Box 1328  
Roseburg OR  
 Party Chief Dean Turner  
 Notes Lynn Sibley  
 Witness \_\_\_\_\_

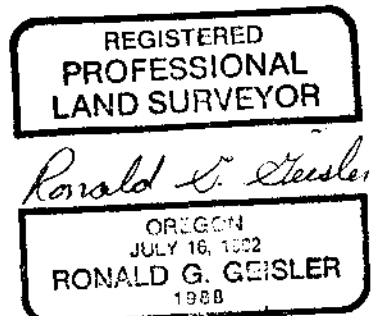

C.S. File No. 63/34-42