

FILED

OREGON CORNER RESTORATION FORM

JUL 24 1986

Section 6 Township 30S Range 9W

County Douglas Date 7-18-86

COUNTY SURVEYOR
DOUGLAS COUNTY, ORE

Corner Designation

NW 1/16

- Condition Report Only
- Not Found
- Renewed
- Unrecorded
- Surveyed In
- Referenced Out

Previous Renewals/Surveys, etc. _____

Monument(s) & Accessories Found: (Condition and Source)

8" Cedar (Down + BROKEN) Bear's N73°E - 16² FT
scribing visible (1984)

Monument Detail

Sketch

2 1/2" Alum Cap on a
1" I.P. extends 3"
Above grd.

T30S R9W
NW 1/16 - S6
1984
PLS-1988

Monument Set (Procedures and Description)

New Accessories

12" Cedar Bear's S34°W - 11² FT AND Scribed
NW 1/16 - S6 - B.T. (1986)

32" FIR (STUMP) Bear's N36°W - 11² FT AND
Scribed NW 1/16 - S6 - B.T. (1986)

Location & Comments

Compass Declination 19° E

Firm/Agency CHAMPION
INTERNATIONAL


Address P.O. Box 1328
Roseburg OR

Party Chief Dean Turner

Notes Lynn Sibley

Witness _____

Surveyor's Seal

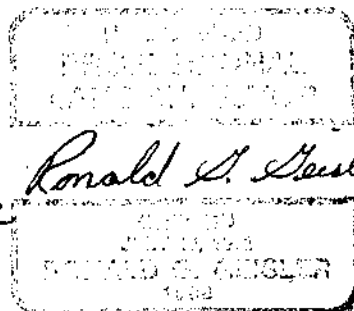

C.S. File No. 63/34 46