


m 104-1
PUBLIC LAND CORNERS

WEYERHAEUSER TIMBER COMPANY
SPRINGFIELD BRANCH

TOWNSHIP 23 S RANGE 3 W

SECTION 19 CORNER W 1/4

COUNTY LANE & DOUGLAS LINE OREGON

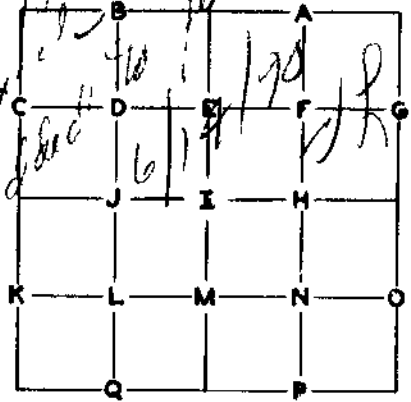

GLO SURVEY RECORD

DATE 1882
CORNER POST

PRESENT CONDITION - (DESCRIBE FULLY -
USE PAGE 2 IF NEEDED FOR EXPLANATION)
POST GONE

FOUND NUMEROUS CRUISER MARKS AND A BLM
PLATE WITH NO DISTANCES OR BEARINGS.

ACCESSORIES

	BEARING-	LINKS-	FEET-
36" FIR	N 10° E	25	
35" FIR	S 64° W	20	

NO TRACE OF THIS BT

NOW 1.2" FIR. FOUND BT 1/4 S, BUT FACE
BEARS S 64° E. I INTERPRET THIS TO BE
AN ERROR IN ORIGINAL NOTES AND MAKE
THIS BEARING N 64° W.

SURVEY RECORD
DATE _____

PRESENT CONDITION _____

CORNER SET: 2" x 4.5" HEMLOCK POST MAG. DECL.: 20° E

BEARING AND DISTANCE TO ABOVE IDENTIFIED SURVEY ACCESSORIES:

BEARING-	FEET-	SURVEY -
N 64° W	12.8	ORIGINAL 35" FIR BT

ACCESSORIES ADDED THIS DATE _____

MAGNETIC DECLINATION _____

	BEARING	FEET	ORIG B T	'W' NAIL	PLATE	BRASS DISC
42" FIR (ORIGINAL BT)	N 64° W	12.8	X	X	X	-
54" FIR STUMP	N 28° E	32.4	-	X	X	-

IDENTIFIED ON PHOTO: _____

INFORMATION ON LOCATION OF CORNER AS NOW SET:

GROUND COVER _____ OG FIR TO WEST, LOGGED TO THE EAST

(USING FORM LINES SKETCH TOPOG AT CORNER ON PAGE 2 PLAT)

SLOPE FACES (GIVE BEARING IN DEGREES) _____ ON MINUS (-) _____ %

FROM CORNER

NORTH _____

SOUTH _____

EAST _____

WEST _____

WORK DONE FOR W T CO

FIELD NOTES IN BOOK: _____

BY _____ DATE FEBRUARY 26, 1957
ENGINEER - SURVEYOR

ASSISTED BY _____ DOUGLAS WARNER
_____ RONALD YOUNG
_____ GORDON WALLER

COPIES SENT TO: _____

UNDER THE SUPERVISION OF:

63/48-2b
SEAL
PAGE 3

PUBLIC LAND CORNERS

M 104-1

WEYERHAEUSER TIMBER COMPANY

SPRINGFIELD BRANCH


APR 24 1987

COUNTY SURVEYOR
DOUGLAS COUNTY, ORE

TOWNSHIP 23 S RANGE 3 W

SECTION 19 CORNER W 1/4

COUNTY LAKE & DOUGLAS LINE OREGON

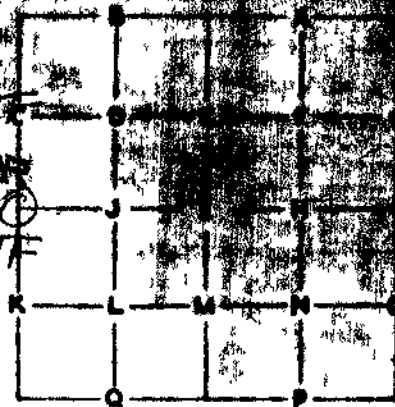

GLO SURVEY RECORD

CORNER POST DATE 88

ACCESSORIES

	BEARING-	LINKS-	FEET-
16" FIR ✓	N 10° P ✓	15 ✓	
1" FIR ✓	S 64° W ✓	20 ✓	

PRESENT CONDITION - (DESCRIBE FULL USE PAGE 2 IF NEEDED FOR EXPLANATION.)
POST ONE

FOUND NUMEROUS USER MARKS AND A B.L.M. PLATE WITH NO DISTANCES OR BEARINGS.

NO TRACE OF THIS PT
"VOID 38" FIR"
"38" 38" FIR" AND "1 1/4 5" SET PAGE BEARS
S 22 E 1 N. FROM THIS TO BE AN ERROR IN ORIGINAL NOTES AND MAKE THIS BEARING N 64° W

SURVEY RECORD DATE

PRESENT CONDITION:

CORNER SET: 1" x 4.5" HEMLOCK POST MAGNETIC DECLINATION: 20° E

BEARING AND DISTANCE TO ABOVE IDENTIFIED SURVEY ACCESSORIES:

BEARING-	FEET-	
N 64° W	48	ORIGINAL 35" FIR PT

ACCESSORIES ADDED THIS DATE

	BEARING-	FEET	ORIG. BT	W ² NAIL	PLATE	BRAS DISC
42" FIR (ORIGINAL BT)	N 64 W	12 8	X	X		
54" FIR STUMP	N 28 E	32.4	X	X		

IDENTIFIED ON PHOTO:

INFORMATION ON LOCATION OF CORNER AS NOW SET
 DESCRIPTION OF GROUND COVER AND GROUND SLOPE AT CORNER OG FIR TO WEST,
LOGGED TO THE EAST

FROM CORNER NORTH _____
 SOUTH _____
 EAST _____
 WEST _____

FILED
 APR 24 1987
 COUNTY SURVEYOR
 DOUGLAS COUNTY ORE
 TF

WORK DONE FOR W T CO

BY Wae ENGINEER - SURVEYOR DATE FEBRUARY 26, 1957

ASSISTED BY DJ A WARRER
RONALD YOUNG
GOR A WALLER

UNDER SUPERVISION OF:

COPIES SENT TO: _____



WEYERHAEUSER TIMBER COMPANY

SPRINGFIELD LUMBER DIVISION SPRINGFIELD OREGON

January 13 1959

Wilfred Haines
Drain Oregon

Dear Wilfred

I am sending you a copy of a report made in February 1957 by Marior Hale which shows what he found at the East $\frac{1}{4}$ corner of Section ~~20~~ Township 23 South Range 4 West. This bears out what you said your man found and it does then commit us to use the reverse bearing. A copy of this has been given to the Douglas County Surveyor.

WEYERHAEUSER TIMBER COMPANY
Springfield Lumber Division

A handwritten signature in cursive script that reads "Lester Calder".

Lester Calder
Regional Land Supervisor

gm
enclosure

6-6-19 -2E