

FILED *Sh*

MAR 5 1987

OREGON CORNER RESTORATION FORM

Section 11 Township 22S Range 12W

COUNTY SURVEYOR
DOUGLAS COUNTY, ORE.

County Douglas Date Feb. 27, 1987

Corner Designation

CN 1/16

- Condition Report Only
- Not Found
- Renewed
- Unrecorded
- Surveyed In
- Referenced Out

Previous Renewals/Surveys, etc. Set in 1968 survey by Surveyor R.J. Hintz.


Monument(s) & Accessories Found: (Condition and Source)
Corner was 3/4" x 36" Iron Pipe.(Found). From which a:

12" Hemlock BT with old face bears S8°W (Record S10°W),
21.6 feet.

14" Hemlock BT with scar bears N58°W (Record N62½°W),
16.5 feet.

Monument Detail

Sketch

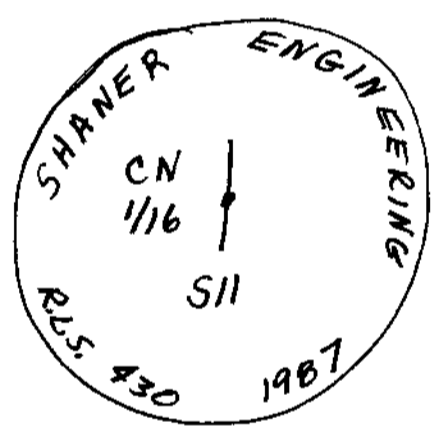

Monument Set (Procedures and Description)
Replaced the 3/4" iron pipe with a 2½" Brass Cap set on a
2" xx 34" iron pipe. See above sketch for markings.

Placed the 3/4" iron pipe alongside the brass cap.

New Accessories

None.

Location & Comments

None.

Compass Declination 190°E

Firm/Agency Shaner Engineering


Address _____

Party Chief B.A. Shaner

Notes _____

Witness _____

Surveyor's Seal

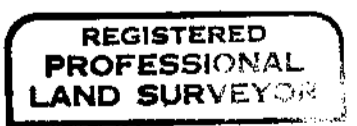

BA Shaner

