

FILED

*SR*

MAR 5 1987

OREGON CORNER RESTORATION FORM

Section 11 Township 22S Range 12W

COUNTY SURVEYOR  
DOUGLAS COUNTY, ORE.

County Douglas Date Feb. 27, 1987

Corner Designation

NE 1/16

- Condition Report Only
- Not Found
- Renewed
- Unrecorded
- Surveyed In
- Referenced Out

Previous Renewals/Surveys, etc. \_\_\_\_\_

Set In 1968 survey by Surveyor R. J. Hintz.

Monument(s) & Accessories Found: (Condition and Source)


Corner found was a 3/4" x 36" iron pipe, from which a:

22" Cedar BT with face bears S30°W, 10.2 feet.

24" Douglas Fir BT stump with face bears N28½°E, 36.2 feet.

Monument Detail

Sketch

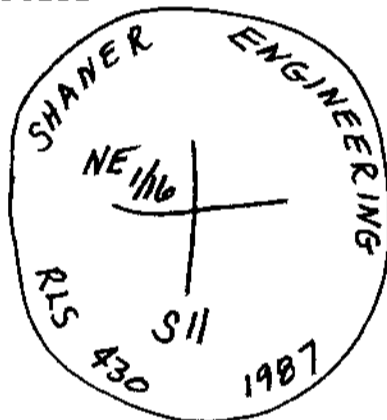

Monument Set (Procedures and Description)

Replaced the 3/4" iron pipe with a 2½" Brass Cap set on a  
2" x 34" iron pipe. See above sketch for markings.

Placed the 3/4" iron pipe alongside the brass cap.

New Accessories

18" Hemlock BT, I scribed "NE 1/16 BT", bears N13°W, 13.3 feet.

Location & Comments

Corner is 90 feet  
North of E-W road.

Compass Declination 19°E

Firm/Agency  
Shaner Engineering

Address \_\_\_\_\_

Party Chief B.A. Shaner

Notes \_\_\_\_\_

Witness \_\_\_\_\_

Surveyor's Seal

REGISTERED  
PROFESSIONAL  
LAND SURVEYOR

*BA Shaner*

OREGON  
OCT. 4, 1957  
BRUCE A SHANER  
430