

FILED

MAR 5 1987

OREGON CORNER RESTORATION FORM

Section 11 Township 225 Range 12W

County Douglas Date Feb. 27, 1987

COUNTY SURVEYOR  
DOUGLAS COUNTY, ORE.

Corner Designation

NW 1/16

- Condition Report Only
- Not Found
- Renewed
- Unrecorded
- Surveyed In
- Referenced Out

Previous Renewals/Surveys, etc.

Set in 1968 Survey by Surveyor R. J. Hintz.

Monument(s) & Accessories Found: (Condition and Source)


Corner found was 3/4" x 46" iron pipe, from which a:

26" Hemlock BT, scribes visible, bears S20°W, 31.8 feet.

36" Hemlock BT, scribes visible, bears N71 1/2°W, 15.5 feet.

Monument Detail

Sketch

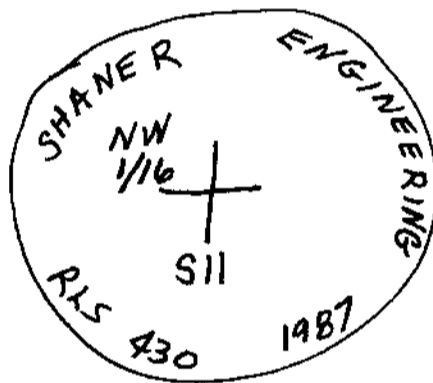

Monument Set (Procedures and Description)

Replaced the 3/4" iron pipe with a 2 1/2" Brass Cap set on a 2" x 34" iron pipe, see above sketch for markings.

Placed the 3/4" iron pipe alongside the brass cap.

New Accessories

None.

Location & Comments

Corner lies South, 80 feet from beaver infested stream & South, 200 feet from E-W Road (dirt).

Compass Declination 19°E

Firm/Agency Shaner Engineering

Address \_\_\_\_\_

Party Chief B.A. Shaner

Surveyor's Seal

REGISTERED  
PROFESSIONAL  
LAND SURVEYOR

*BA Shaner*

OREGON  
OCT. 4, 1957  
BRUCE A SHANER  
430

Notes \_\_\_\_\_

Witness \_\_\_\_\_