

FILED

JR

MAY 29 1987 TF

OREGON CORNER RESTORATION FORM

Section 1 Township 23S Range 10W

County DOUGLAS Date 4/10/87

COUNTY SURVEYOR  
DOUGLAS COUNTY, ORE.

Corner Designation

CLOSING SECTION CORNER  
SECTIONS 1 & 2

- Condition Report Only
- Not Found
- Renewed
- Unrecorded
- Surveyed In
- Referenced Out

Previous Renewals/Surveys, etc.

1878 GLO Survey, 1894 GLO Survey, 1906 GLO Survey,  
OSBF Survey M10-19 / BLM Survey 1970

Monument(s) & Accessories Found: (Condition and Source)



OREGON STATE BOARD OF FORESTRY BEARS CAP "1957"

34" FIR, S46 1/4° E, 20.0' - 1878 GLO (RECORDED S25° E)

20" FIR, S47 1/2° W, 14.3' - OSBF

42" FIR, S 88° W, 31.6' - 1878 GLO - BARK SCRIBED

Monument Detail

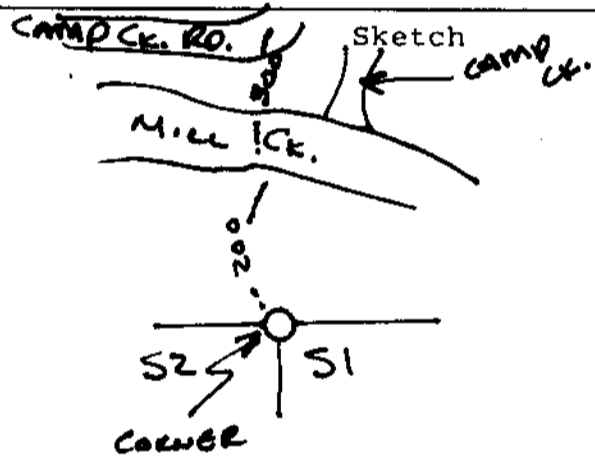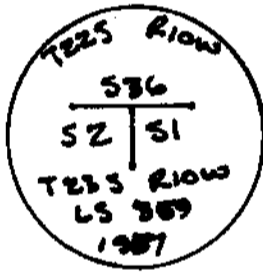

Monument Set (Procedures and Description)

New Accessories

Location & Comments

CORNER LIES ON TOP  
OF ROCK BLUFF APPROX.  
250' SOUTH OF MILL  
CR. AND 500' SOUTH  
OF CAMP CR. RD @  
POINT WHERE ROAD  
HEADS NORTH ALONG  
CAMP CR.  
6 FOOT ALUM. FENCE  
POST & SIGN ALONGSIDE

Compass Declination 20°  
Firm/Agency PEEL BAKER  
LAND SURVEYING  
Address 1212 LANCASTER ST  
EUGENE OREGON  
Party Chief DAN BAKER  
Notes \_\_\_\_\_  
Witness DAVE STANLEY

Surveyor's Seal

