

CERTIFIED RECORD OF LAND CORNER MONUMENTATION

History of original corner establishment:


See C.S. file 58/176

FILED

vl

AUG 6 1987

COUNTY SURVEYOR
DOUGLAS COUNTY, ORE.

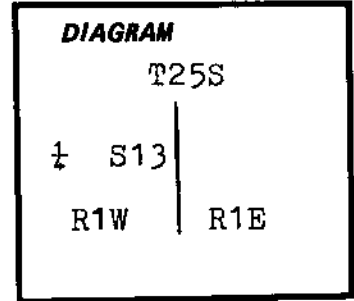

Description of corner evidence found:

Found 1978 Brass cap set by PLS 866, properly marked, from which:

- A 36" Fir stump bears S26*55'W, 20.8 feet.
- A 12" Cedar stump bears N44*05'W, 55.8 feet.
- A 16" Cedar bears S20*55'W, 77.8 feet.
- A 6' steel fence post bears N45*56'W, 55.8 feet.

Description of monument and accessories established to perpetuate the original location of this corner:

New Bearing Tree:

A 8" D. Fir bears N37*W, 7.0 feet with single blaze scribed "1/4 S13 RS1035 BT". A 1/2" brass washer marked "RLS 1035" is nailed flush to lower end of blaze.

I hereby certify the above corner point was perpetuated as hereon described on June 11, 1987. U.S.F.S. Bearing tree signs and monument signs were placed on all B.T.'s without them and a 6" red band was painted around each B.T.

REGISTERED
PROFESSIONAL
LAND SURVEYOR

Gerald V. Nygren

OREGON
GERALD V. NYGREN
AUGUST 22, 1975
1035

Office of.....Surveyor..... County of.....Douglas.....
 State of.....Oregon....., I hereby certify that the within instrument was filed in this office
 for record on the...6... day of....August....., 19.87
 ...Fritz Ingram..... by *Virginia R. Paugen*.....
 (COUNTY OFFICIAL) (DEPUTY)

#54 T 25-1E ✓
#157 T 25-1W ✓

C.S. File No. 63/50-9 ✓