

CERTIFIED RECORD OF LAND CORNER MONUMENTATION

History of original corner establishment:


See C.S. file 58/176

FILED



AUG 6 1987

COUNTY SURVEYOR
DOUGLAS COUNTY, ORE.

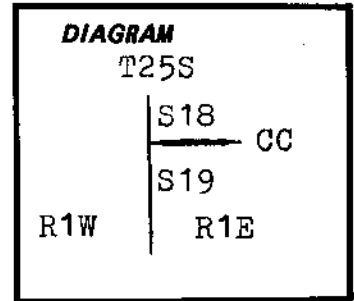

Description of corner evidence found:

Found 1927 G.L.O. Brass cap, properly marked, from which:

- A 30" Cedar snag bears S28°E, 6.4 feet.
- A 9" D. Fir snag (down) bears S40°E, 27.7 feet.
- A 10" D. Fir bears N77°E, 80.5 feet.
- A 15" D. Fir snag bears S07°30'E, 31.3 feet.


Description of monument and accessories established to perpetuate the original location of this corner:

New Bearing Tree:

A 6" D. Fir bears N02°W, 21.5 feet scribed "x" on small upper blaze and "BT" on small lower blaze. A 1/2" brass washer marked "RLS 1035" is nailed flush to lower blaze.

I hereby certify the above corner point was perpetuated as hereon described on June 11, 1987. U.S.F.S. Bearing tree signs and monument signs were placed on all B.T.'s without them and a 6" red band was painted around each B.T.

REGISTERED
PROFESSIONAL
LAND SURVEYOR

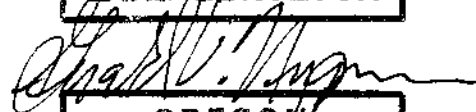

OREGON
GERALD V. NYGREN
AUGUST 22, 1975
1035

Office of... Surveyor..... County of... Douglas.....
 State of... Oregon....., I hereby certify that the within instrument was filed in this office
 for record on the..6..... day of... August....., 19..87
 Fritz Ingram..... by Virginia A. Lingen.....
 (COUNTY OFFICIAL) (DEPUTY)

#53 T25-1E X
#156 T25-1W X

63/50-10 C