

FILED

JK

OREGON CORNER RESTORATION FORM

SEP 20 1989

Section 18 Township 19S Range 8W

County Douglas Date 09-02-89

COUNTY SURVEYOR
DOUGLAS COUNTY, ORE.

CORNER DESIGNATION


Center $\frac{1}{4}$ Corner
Section 18

- Condition Report Only
- Not Found
- Renewed
- Unrecorded
- Surveyed In
- Referenced Out

Previous Renewals/Surveys, etc. Original G.L.O. Survey by C.M. Collier in 1891. Also a survey by the Eugene District of Bureau of Land Management dated October 1974, see map M57-31. Also corner renewal by Roberts Surveying dated 11-26-86.
Monument(s) & Accessories Found: (Condition and Source)

Found 1986 International Paper Company aluminum pipe and cap set by Roberts Surveying on 11-26-86. Corner is in logged unit.

- 16" Fir Stump, S77E, 31.0' (Scar Vis.), 1974 BT. Rec. S77 $\frac{1}{2}$ E, 31.2'
- 28" Fir Stump, N36W, 48.0' (Scar Vis.), 1974 BT. Rec. N36 $\frac{1}{2}$ W, 48.1'
- 36" Fir Stump, N28E, 41.4' (Scar Vis.), 1974 BT. Rec. N27E, 41.0'
- 24" Alder Stump, S54E, 8.80' to R.R. spike in base. 1985 R.P.
- 36" Fir Stump, N31E, 39.60' to R.R. spike in base. 1985 R.P.

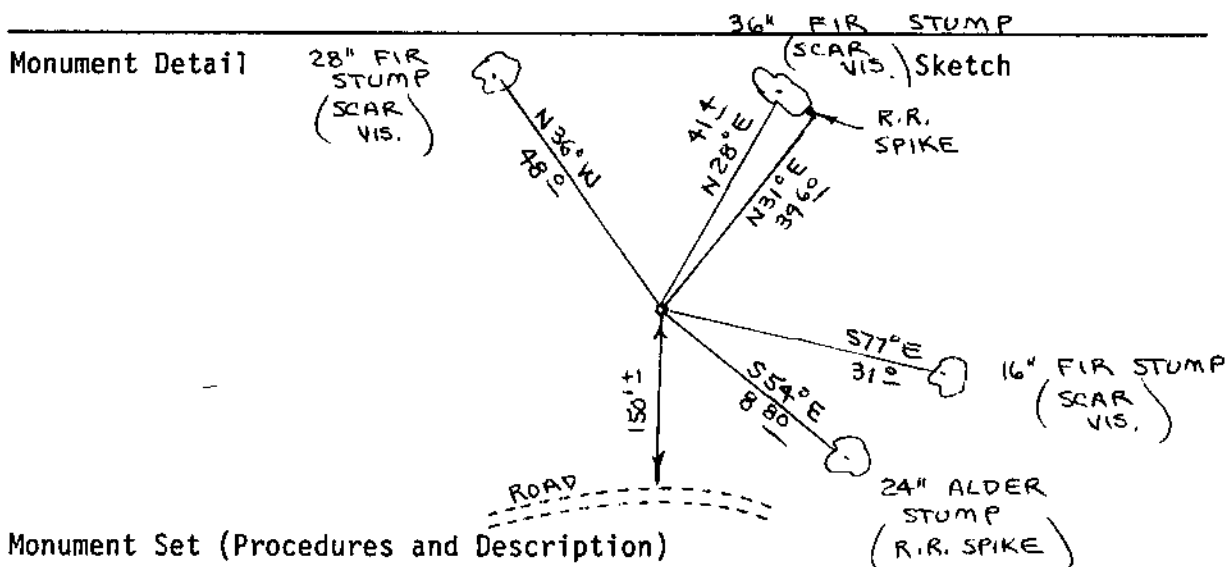

Monument Set (Procedures and Description)

New Accessories

- Soaked sides and tops of stumps with a wood preservative.
- Covered tops of stumps with 0.020 thick sheets of aluminum.
- 24" Alder stump not treated or covered.

Location & Comments

Corner lies on N.E. slope about 150' North of road.

Compass Declination 20 $\frac{1}{2}$

Firm/Agency Roberts Surveying Inc.

Address 29 West 29th St. Eugene, Oregon 97405

Party Chief Ted Baker

Notes _____

Witness Norman Hamar

Surveyor's Seal

