

FILED

JK

DEC 21 1987

OREGON CORNER RESTORATION FORM
Section 18 Township 19S Range 8W
County Douglas Date 11-04-85

COUNTY SURVEYOR
DOUGLAS COUNTY, ORE.

CORNER DESIGNATION


Center $\frac{1}{4}$ Corner
Section 18

- Condition Report Only
- Not Found
- Renewed
- Unrecorded
- Surveyed In
- Referenced Out

Previous Renewals/Surveys, etc. Original G.L.O. Survey by C.M. Collier in 1891. Also 1974 survey by Eugene District of Bureau of Land Management dated October 1974. See map M57-31.

Monument(s) & Accessories Found: (Condition and Source)

Found $\frac{3}{4}$ " x 24" iron pin set firmly in ground.
16" Fir, S77E, 31.0' (Scar Vis.), 1974 BT. Record S77 $\frac{1}{4}$ E, 31.2'
28" Fir, N36W, 48.0' (Scar Vis.), 1974 BT. Record N36 $\frac{1}{2}$ W, 48.1'
36" Fir, N28E, 41.4' (Scar Vis.), 1974 BT. Record N26 $\frac{3}{4}$ E, 41.0'

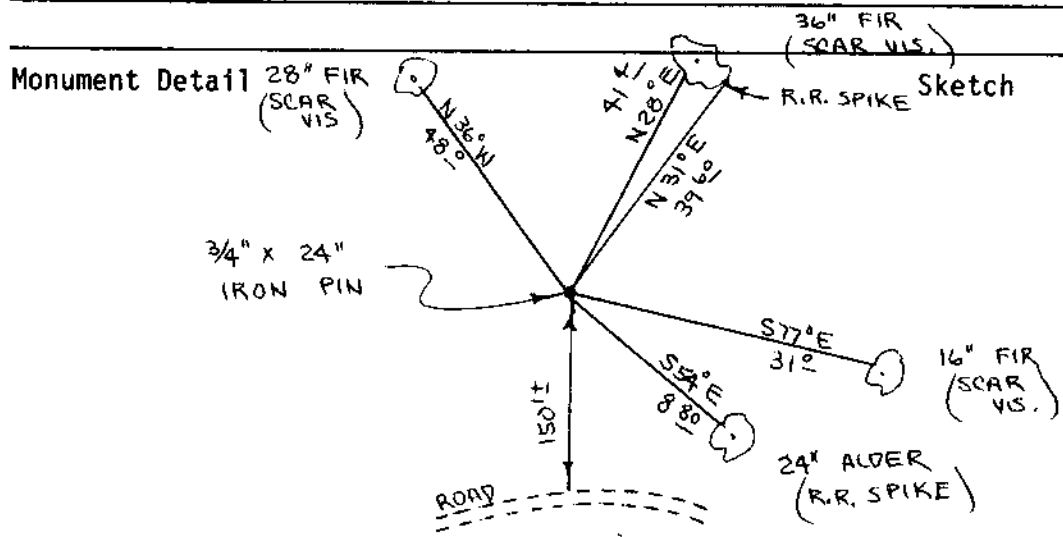

Monument Set (Procedures and Description)


New Accessories

Set additional corner R.P.'s because of planned logging activity in near future.
24" Alder, S54E, 8.80' to R.R. spike in base of tree.
36" Fir, N31E, 39.60' to R.R. spike in base of tree.

Location & Comments

Corner lies on N.E. slope about 150' North of road.
Compass Declination 20 $\frac{1}{2}$
Firm/Agency Roberts Surveying Inc.
Address 29 West 29th St. Eugene, Oregon 97405
Party Chief Les Roberts
Notes _____
Witness Ted Baker

Surveyor's Seal

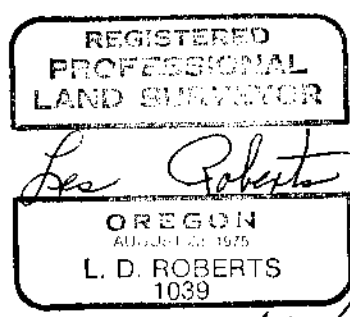

C.S. File No. 63/50-12