

FILED

DEC 21 1987

OREGON CORNER RESTORATION FORM


Section 30 Township 20S Range 9W

County Douglas Date 8-21-85

COUNTY SURVEYOR  
DOUGLAS COUNTY, ORE.

CORNER DESIGNATION

East  $\frac{1}{4}$  Corner  
Section 30

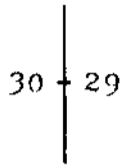


- Condition Report Only
- Not Found
- Renewed
- Unrecorded
- Surveyed In
- Referenced Out

Previous Renewals/Surveys, etc. Original G.L.O. Survey by William Thiel in 1891, Thomas A. Tillman and Joseph S. Gawron G.L.O. Survey in 1953-1954. Survey M90-28 by Roberts Surveying in 1982.

Monument(s) & Accessories Found: (Condition and Source)

- Found 1953 G.L.O. Brass Cap set firmly in ground.
- 60" Fir Snag, N43W, 60.5' (No. Marks), 1877 B.T. Rec. N44 $\frac{1}{2}$ W, 58.1'
- 20" Maple, S39E, 22.1' (Scar Vis.), 1953 B.T. Rec. S36 E, 23.1'
- 24" Maple, N53W, 60.4' (Scribe Vis.), 1953 B.T. N53 W, 59.4'

Monument Detail

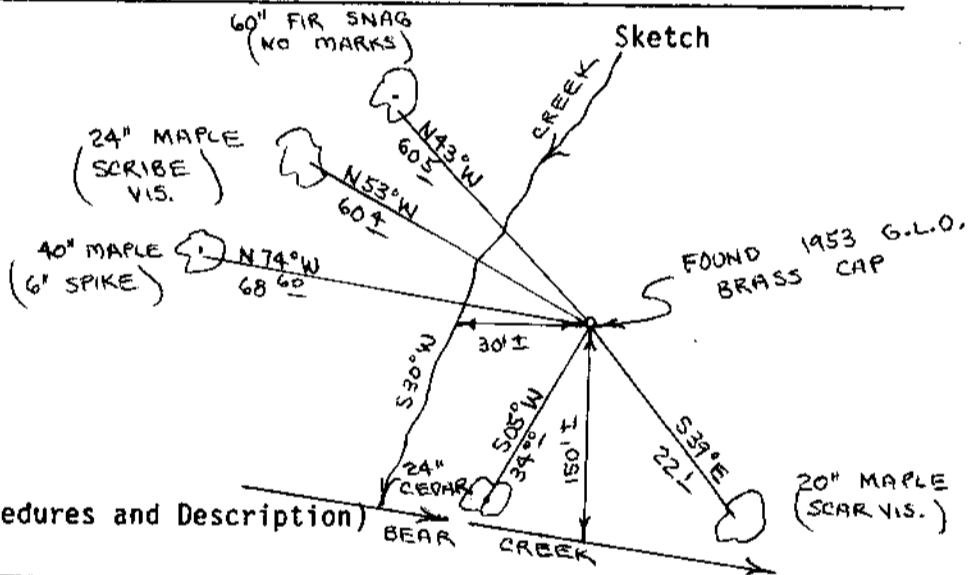

Monument Set (Procedures and Description)

New Accessories

Set additional corner R.P.'s because of planned logging activity in near future.

24" Cedar, S05W, 34.00 to 6" spike driven in base of tree.

40" Maple, N74W, 68.60' to 6" spike driven in base of tree.

Location & Comments

Corner lies about 150' North of Bear Creek and about 30' feet East of small side creek

Compass Declination  $20\frac{1}{2}$

Firm/Agency Roberts Surveying Inc.

Address 29 West 29th St. Eugene, Oregon 97405

Party Chief Ted Baker

Surveyor's Seal

REGISTERED PROFESSIONAL LAND SURVEYOR

*L. D. Roberts*  
OREGON  
AUGUST 22, 1975  
L. D. ROBERTS  
1039

Notes

Witness Stu Duce