

OREGON CORNER RESTORATION FORM

Section 35 Township 20S Range 10W

County DOUGLAS Date 3/11/87

Corner Designation

CLOSING CORNER  
SECTIONS 35 & 36

- Condition Report Only
- Not Found
- Renewed
- Unrecorded
- Surveyed In
- Referenced Out

Previous Renewals/Surveys, etc.

1892 ~~BLM~~ GLO - ORIGINAL, 1919 GLO (SET CC), 1951  
BLM

Monument(s) & Accessories Found: (Condition and Source)


FOUND - 2" IRON PIPE WITH GLO BRASS CAP "1951"

28" HEMLOCK STUMP, N46°E, 36/ks  
(CALLED FIR in 1919)

28" FIR STUMP, N 30 1/2° W, 13/ks

Monument Detail

Sketch

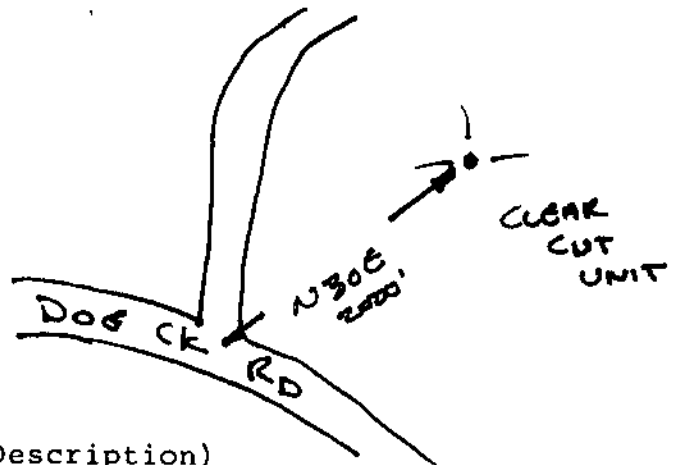

Monument Set (Procedures and Description)

New Accessories

Location & Comments

MONUMENT LIES IN FRESHLY CUT CLEAR CUT UNIT AND BOTH BT'S ARE NOW STUMPS

Compass Declination 20°

Firm/Agency PEEL BAKER LAND SURVEYING

Address 1262 LAWRENCE EUGENE, OREGON 97401

Party Chief DAN BAKER

Notes \_\_\_\_\_

Witness DARYL STANLEY

Surveyor's Seal

