


OREGON CORNER RESTORATION FORM

Section 16 Township 22S Range 12W

County Douglas Date 7-10-87

CORNER DESIGNATION

N.E. Corner
Section 16

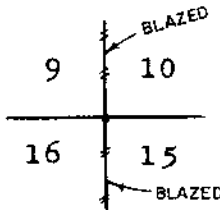

- Condition Report Only
- Not Found
- Renewed
- Unrecorded
- Surveyed In
- Referenced Out


Previous Renewals/Surveys, etc. Original G.L.O. Survey by William thiel in 1889. Survey M92-57 by Robert Ward in 1982 and Survey RM3-59 by Bruce Shaner in 1982.

Monument(s) & Accessories Found: (Condition and Source)

Found 1982 Brass Cap and 2 1/2" iron pipe set in C.S. M92-57.

- 60" Spruce Stump, S06W, 55.7' (Scribe Vis.), 1889 BT. Rec. S0 1/2 W, 53.5'
- 12" Hemlock, S25E, 17.0' (Scribe Vis.), 1982 BT. Rec. S22E, 17.1'
- 12" Alder, N46E, 38.4' (Bark Scribed), 1982 BT. Rec. N48E, 38.9'
- 16" Alder, N31W, 37.6' (Bark Scribed), 1982 BT. Rec. N30W, 37.9'
- 16" Hemlock, S43W, 55.4' (Scribe Vis.), 1982 BT. Rec. S44W, 55.0'

Monument Detail

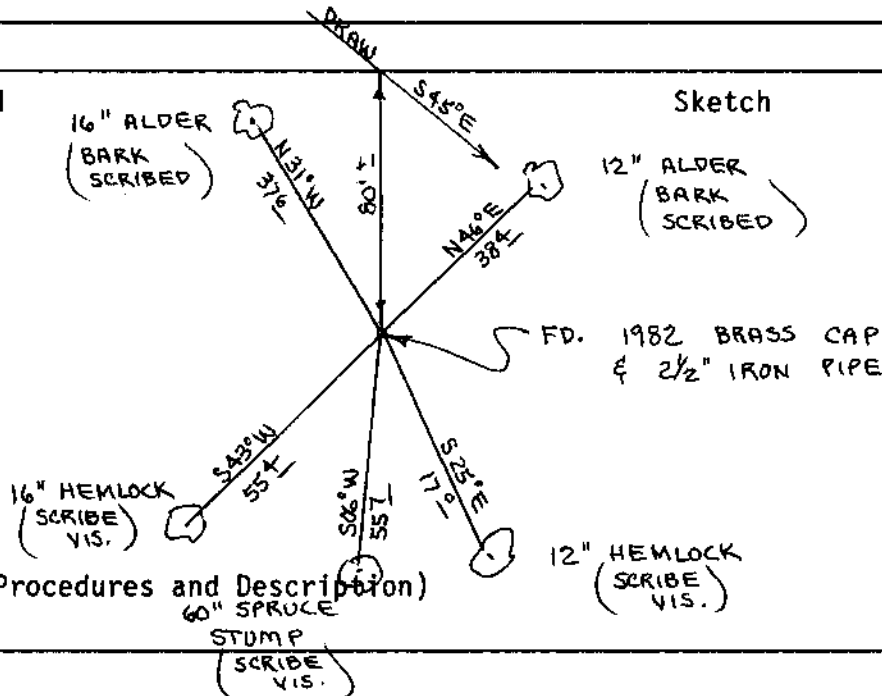

Monument Set (Procedures and Description)

New Accessories

Set 60" aluminum post, with land survey monument sign attached to, beside brass cap. Painted all B.T.'s red.

Location & Comments

Corner lies on East slope about 80' South of small draw. Draw bears S45E and N45W.
Compass Declination 20 1/2
Firm/Agency Roberts Surveying Inc.
Address 29 west 29th St. Eugene, Oregon 97405
Party Chief Ted Baker
Notes
Witness Jim Metzler

Surveyor's Seal

REGISTERED
PROFESSIONAL
LAND SURVEYOR

L. D. Roberts
 OREGON
 AUGUST 22 1975
 L. D. ROBERTS
 1039