


OREGON CORNER RESTORATION FORM

Section 16 Township 22S Range 12W

County Douglas Date 7-15-87

CORNER DESIGNATION

East  $\frac{1}{4}$  Corner  
Section 16

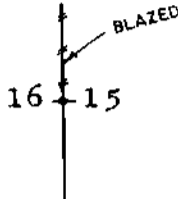

- Condition Report Only
- Not Found
- Renewed
- Unrecorded
- Surveyed In
- Referenced Out

Previous Renewals/Surveys, etc. Original G.L.O. Survey by William Thiel in 1889. Survey M92-57 by Robert Ward in 1982.


Monument(s) & Accessories Found: (Condition and Source)

Found 1982 Brass Cap and 2 1/2" iron pipe set in C.S. M92-57.

10" Fir . N19E, 11.0' (Scribe Vis.), 1982 BT. Rec. N20E, 10.9'

16" Hemlock, S46W, 7.6' (Scribe Vis.), 1982 BT. Rec. S46W, 7.3'

Monument Detail

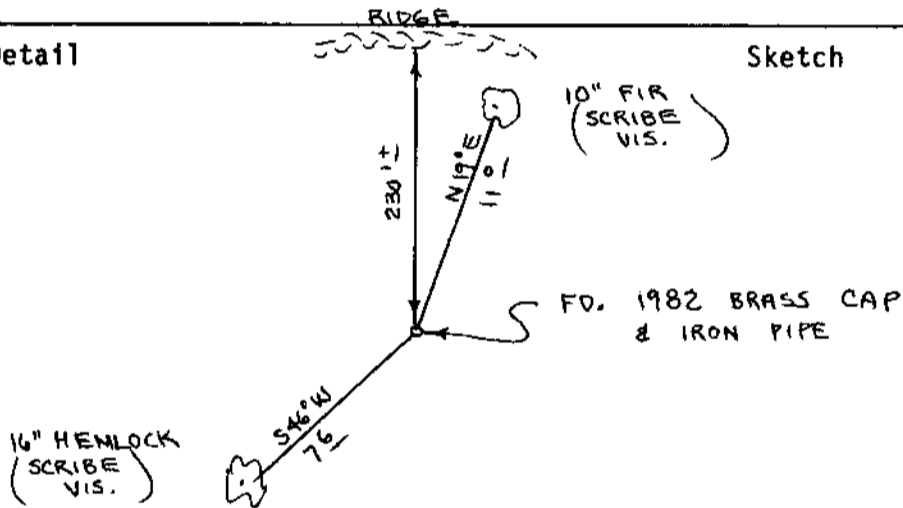

Monument Set (Procedures and Description)

New Accessories

Set 60" aluminum post, with land monument survey sign attached to, beside brass cap. Painted all B.T.'s red.

Location & Comments

Corner lies on South slope about 230 feet South of East-West Ridge

Compass Declination 20 1/2

Firm/Agency Roberts Surveying Inc.

Address 29 West 29th St. Eugene, Oregon 97405

Party Chief Ted Baker

Notes \_\_\_\_\_

Witness Jim Metzler

Surveyor's Seal

