

M105-29

FILED

DEC 29 1987

OREGON CORNER RESTORATION FORM


Section 10 Township 22S Range 12W

County Douglas Date 4-09-87

COUNTY SURVEYOR  
DOUGLAS COUNTY, ORE

CORNER DESIGNATION

West  $\frac{1}{4}$  Corner  
Section 10

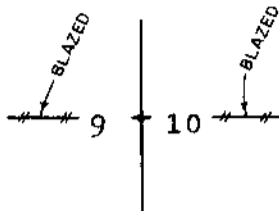

- Condition Report Only
- Not Found
- Renewed
- Unrecorded
- Surveyed In
- Referenced Out

Previous Renewals/Surveys, etc. Original G.L.O. Survey by William Thiel in 1889. Survey M98-54 by Ron Stuntzner in 1985 and Survey RM3-59 by Bruce Shaner in 1982.


Monument(s) & Accessories Found: (Condition and Source)

Found 1982 Brass Cap and 2 1/2" iron pipe set in C.S. RM3-59.  
20" Fir . S80E, 84.2'(Scribe Vis.) , 1982 BT. Rec. S80E, 84.3'  
30" Hemlock, S47W, 74.6'(Bark Scribed), 1982 BT. Rec. S46W, 75.0'

Monument Detail

Sketch

FD. 1982 BRASS CAP  
& 2 1/2" IRON PIPE

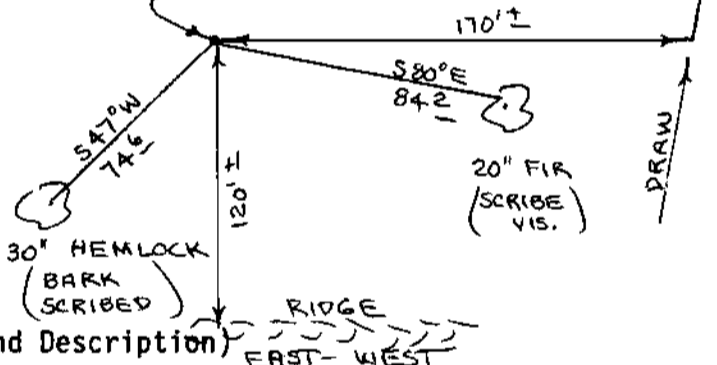

Monument Set (Procedures and Description)

Set 60" aluminum post, with land survey monument sign attached to, beside brass cap. Painted all B.T.'s red.

New Accessories

Location & Comments

Corner lies on East slope about 170 feet West of small draw.  
Draw bears N10E and S10W. A main East-West ridge bears South about 120'  
Compass Declination 20 1/2  
Firm/Agency Roberts Surveying Inc.  
Address 29 West 29th St. Eugene, Oregon 97405  
Party Chief Ted Baker  
Notes \_\_\_\_\_  
Witness Jim Metzler

Surveyor's Seal



C.S. File No. 63/55-5