

M105-29

FILED

JR

DEC 29 1987

OREGON CORNER RESTORATION FORM


Section 10 Township 22S Range 12W

County Douglas Date 04-27-87

COUNTY SURVEYOR
DOUGLAS COUNTY, ORE.

CORNER DESIGNATION

Center $\frac{1}{4}$ Corner
Section 10

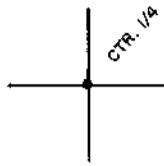

- Condition Report Only
- Not Found
- Renewed
- Unrecorded
- Surveyed In
- Referenced Out

Previous Renewals/Surveys, etc. Original G.L.O. Survey by William Thiel in 1889. Survey RM3-59 by Bruce Shaner in 1982.

Monument(s) & Accessories Found: (Condition and Source)

Found 1982 Brass Cap and 2 1/2" iron pipe set in C.S. RM3-59.


10" Spruce, S36W, 43.5' (Scribe Vis.), 1982 BT. Rec. S35W, 43.0'

18" Alder, N89E, 8.6' (Bark Scribed), 1982 BT. Rec. N87E, 8.8'

30" Cedar Snag, N63W, 80.3' (Scribe Vis.), 1982 BT. Rec. N65W, 80.3'

Monument Detail

Sketch

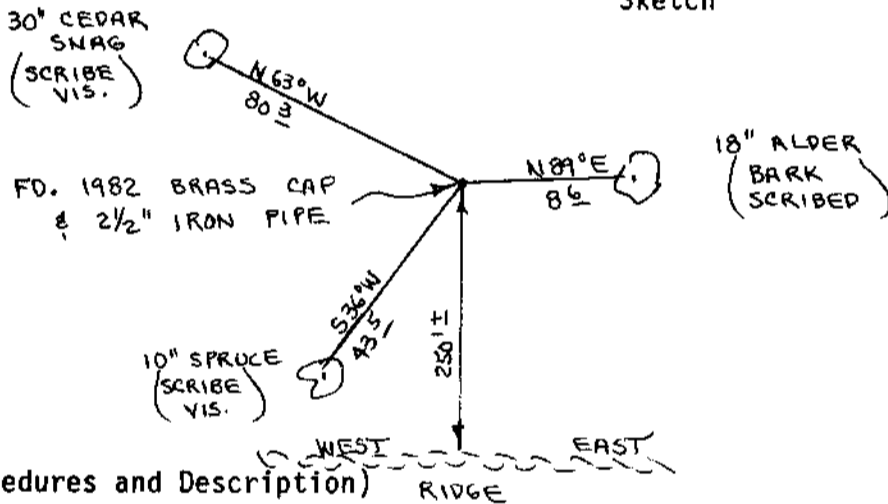

Monument Set (Procedures and Description)

New Accessories

Set 60" aluminum post, with land survey monument sign attached to, beside brass cap, Painted all B.T.'s red.

Location & Comments

Corner lies on North slope about 250 feet North of main East-West ridge.

Compass Declination 20 1/2
Firm/Agency Roberts Surveying Inc.
Address 29 West 29th St. Eugene, Oregon 97405
Party Chief Ted Baker
Notes _____
Witness Jim Metzler

Surveyor's Seal



C.S. File No. 63/55-7