

M105-29

FILED

JK  
DEC 29 1987

OREGON CORNER RESTORATION FORM


Section 10 Township 22S Range 12W

County Douglas Date 04-21-87

COUNTY SURVEYOR  
DOUGLAS COUNTY, ORE.

CORNER DESIGNATION

C.S. 1/16 Corner  
Section 10.

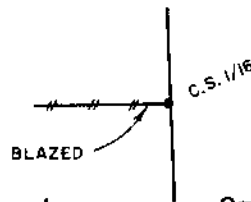


- Condition Report Only
- Not Found
- Renewed
- Unrecorded
- Surveyed In
- Referenced Out

Previous Renewals/Surveys, etc. Original G.L.O. Survey by  
William Thiel in 1889. Survey RM3-59 by Bruce Shaner in 1982.

Monument(s) & Accessories Found: (Condition and Source)

Found 1982 Brass Cap and 2 1/2" iron pipe set in C.S. RM3-59.  
12" Hemlock, N80W, 32.8' (Scribe Vis.), 1982 BT. Rec. N79W, 32.5'  
14" Fir, S04E, 20.0' (Scribe Vis.), 1982 BT. Rec. S03E, 20.0'  
14" Fir, N04W, 55.4' (Scribe Vis.), 1982 BT. Rec. N04W, 55.2'

Monument Detail

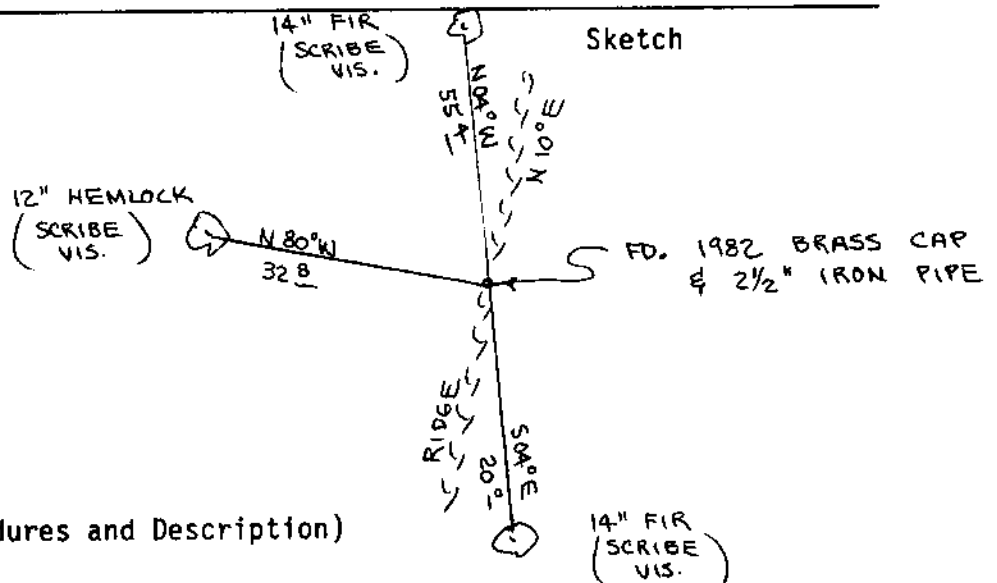

Monument Set (Procedures and Description)

New Accessories

Set 60" aluminum post, with land survey monument sign attached  
to, beside brass cap. Painted all B.T.'s red.

Location & Comments

Corner lies on spur Compass Declination 20 1/2  
ridge. Ridge bears Firm/Agency Roberts  
N10E and S10W. Surveying Inc.  
Address 29 West 29th St.  
Eugene, Oregon 97405  
Party Chief Ted Baker  
Notes  
Witness Jim Metzler

Surveyor's Seal



C.S. File No. 63/55-8