

M105-29

FILED

JK

DEC 29 1987

OREGON CORNER RESTORATION FORM

Section 10 Township 22S Range 12W

County Douglas Date 09-18-87

COUNTY SURVEYOR
DOUGLAS COUNTY, ORE.

CORNER DESIGNATION

S.W. 1/16 Corner
Section 10




- Condition Report Only
- Not Found
- Renewed
- Unrecorded
- Surveyed In
- Referenced Out

Previous Renewals/Surveys, etc. Original G.L.O. Survey by William Thiel in 1889. Survey RM3-59 by Bruce Shaner in 1982.

Monument(s) & Accessories Found: (Condition and Source)

No monument found.

Monument Detail

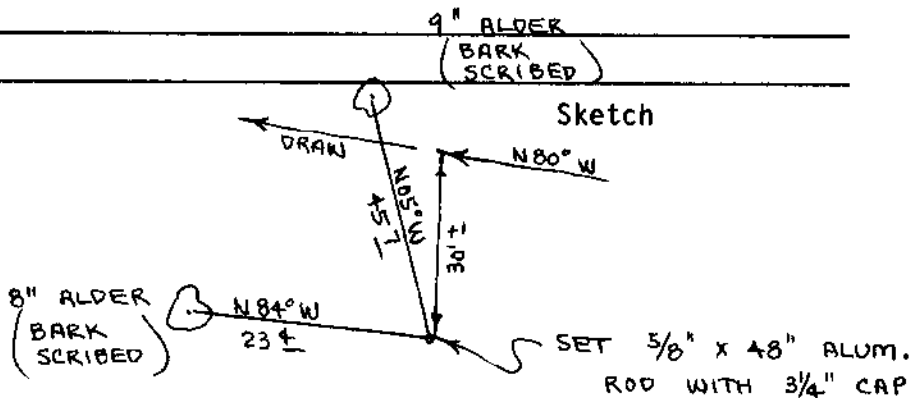

Monument Set (Procedures and Description)

Set 5/8" x 48" aluminum rod with 3 1/4" aluminum cap. Buried purple magnetic marker beside 48" aluminum rod. Set 60" aluminum post, with land survey monument sign attached to, beside aluminum rod.


New Accessories

- 8" Alder, N84W, 23.4' (Bark Scribed/Painted Red)
- 9" Alder, N05W, 45.7' (Bark Scribed/Painted Red)

Location & Comments

Corner lies on West slope about 30' South of small draw. Draw bears N80W and S80E. Compass Declination 20 1/2
Firm/Agency Roberts Surveying Inc.
Address 29 West 29th St. Eugene, Oregon 97405
Party Chief Ted Baker
Notes
Witness Jim Metzler

Surveyor's Seal

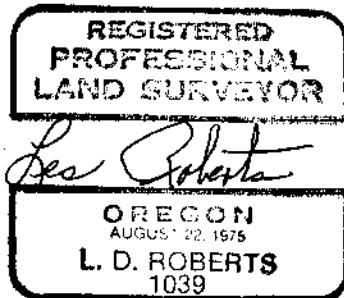

C.S. File No. 63/55-9