

OREGON CORNER RESTORATION FORM

Section 9 Township 22S Range 12W

COUNTY SURVEYOR  
DOUGLAS COUNTY, ORE.

County Douglas Date 04-02-87

CORNER DESIGNATION

South  $\frac{1}{4}$  Corner  
Section 9



- Condition Report Only
- Not Found
- Renewed
- Unrecorded
- Surveyed In
- Referenced Out


Previous Renewals/Surveys, etc. Original G.L.O. Surveys by Harvey Gordon in 1857 and by William Thiel in 1889. Survey M98-54 by Ron Stuntzner in 1985.

Monument(s) & Accessories Found: (Condition and Source)

- Found 1985 Brass Cap and 2" iron pipe set in C.S. M98-54.
- 30" Downed Hemlock, N60W, 25.5' (Scribe Vis.), 1889 BT. Rec. N59W, 24.4'
- 60" Spruce Stump, S62E, 24.4' (No Marks), 1889 BT. Rec. S60E, 25.7'
- 16" Fir, S27W, 12.0' (Scribe Vis.), 1985 BT. Record S28W, 12.0'
- 22" Fir, East, 19.5' (Scribe Vis.), 1985 BT. Record N89E, 19.5'

Monument Detail

Sketch

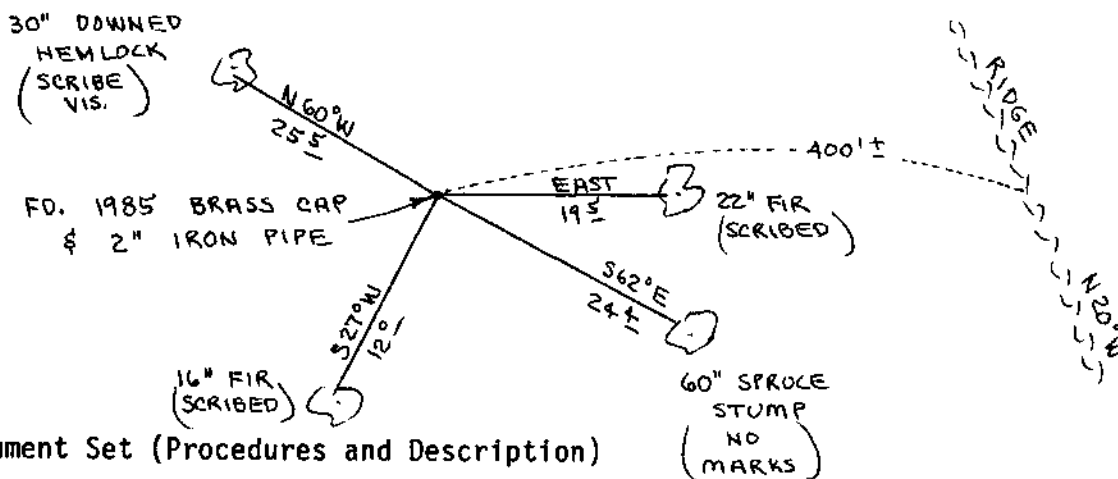

Monument Set (Procedures and Description)

New Accessories


Set 60" aluminum post, with land survey monument sign attached to, beside brass cap. Painted all B.T.'s red.

Location & Comments

Corner lies on South slope about 400 feet West of ridge. Ridge bears N20W and S20E

Compass Declination 20 $\frac{1}{2}$   
 Firm/Agency Roberts Surveying Inc.  
 Address 29 West 29th St. Eugene, Oregon 97405  
 Party Chief Ted Baker  
 Notes \_\_\_\_\_  
 Witness Jim Metzler

Surveyor's Seal

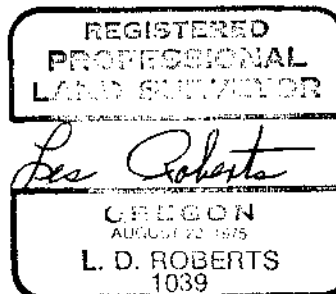

C.S. File No. 63/55-12