

FILED

APR 8 1988

OREGON CORNER RESTORATION FORM

Section 12 Township 28S Range 4W

COUNTY SURVEYOR
DOUGLAS COUNTY, ORE.

County DOUGLAS Date 4-7-88 (VISITED 3-28-88)

Corner Designation

S.W. Sec. Cor.

- Condition Report Only
- Not Found
- Renewed
- Unrecorded
- Surveyed In
- Referenced Out

Previous Renewals/Surveys, etc. Co. SURVEYOR SET BCIP
FROM ORIGINAL B.T.'s IN 1961. SEE CORNER RENEWALS #75
& #19. ALSO SEE 1965 BLM DEPENDENT RESURVEY.

Monument(s) & Accessories Found: (Condition and Source)

- 56" ORIGINAL FIR BEARS S7°E, 29.7' (Rec. = S2°E) BARK SCRIBING VISIBLE
- 56" " " " N15°W, 23.1' BARK SCRIBING VISIBLE
- 10" HEMLOCK BEARS S76°E, 38.2' (Rec. = 38.7') CLOSED FACE (1961)
- 10" CEDAR BEARS S19°W, 39.0' " " "
- 12" MAPLE BEARS N55°W, 9.9' (Rec. = 10.4') " " "


AN ALDER MARKED BY BURON IS DOWN

Monument Detail

2 1/2" BRASS CAP SET ON A
1" IRON PIPE.

Sketch

Co. SURVEYOR'S OFFICE
T28S R4W

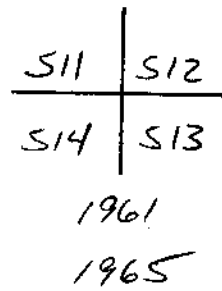


Monument Set (Procedures and Description)

New Accessories

Location & Comments

1974 BLM P/L METAL TAGS Compass Declination 20°E
ALONG W. LINE SEC. 12 Firm/Agency CHAMPION
CORNER APPROX. 15' INTL. CORP.
NORTH OF CREEK FLOWING Address P.O. Box 1328
EAST. ROSEBURG, OR. 97470
 Party Chief R. GIESLER
 Notes R. HANSON
 Witness D. GORDON

Surveyor's Seal

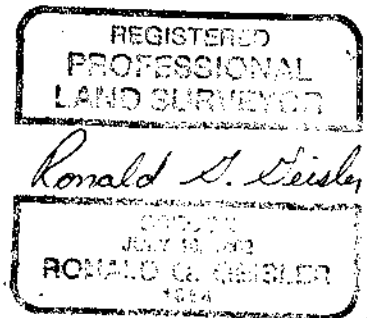

C.S. File No. 63/60-2