

FILED TF

OREGON CORNER RESTORATION FORM

JUL 15 1987

Section 34 Township 25S Range 2W

COUNTY SURVEYOR
DOUGLAS COUNTY, ORE.

County Douglas Date 6-30-87

Corner Designation

Closing Corner

- Condition Report Only
- Not Found
- Renewed
- Unrecorded
- Surveyed In
- Referenced Out

Previous Renewals/Surveys, etc.

Monument(s) & Accessories Found: (Condition and Source)

24" D. FIR STUMP Bears S 14 1/4° W - 353 FT
FACE cut off (1959)

Monument Detail

3 1/2" B.C. on a 2 1/2" I.P.
extends 4" Above grd;
Also found BASALT STONE
Alongside monument

Sketch

T25S R2W
S34
S4/S3
T26S R2W

Monument Set (Procedures and Description)


New Accessories

15" D. FIR Bears S55°E - 132 FT - Scribed
"T26S - R2W - S3 - C.C. - B.T" 1987

Location & Comments

Compass Declination 19°E
Firm/Agency CHAMPION
International
Address P.O. Box 1328
Roseburg OR.
Party Chief Lynn Sibley
Notes Draw TURNER
Witness _____

Surveyor's Seal

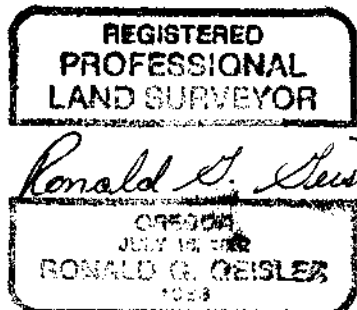

C.S. File No. 63/62-3 C

#141 T. 26-24
#121 T. 25-24