

FILED TF

OREGON CORNER RESTORATION FORM

JUL 15 1987

Section 27 Township 26S Range 2W

COUNTY SURVEYOR
DOUGLAS COUNTY, ORE.

County Douglas Date 6-30-87

Corner Designation

E 1/4 - 27 only

- Condition Report Only
- Not Found
- Renewed
- Unrecorded
- Surveyed In
- Referenced Out

Previous Renewals/Surveys, etc. _____

Monument(s) & Accessories Found: (Condition and Source)

6" Hemlock leaning Badly Bear's N62°W - 11 1/2 FT
(Rec. 10 1/2 FT) Scribing Visible (1981)

12" Hemlock now down & uprooted Bear's N30°30'W -
20 FT to root Hole - scribing visible (1981)

Monument Detail

2 1/2" A.C. on a 1" I.P.
extends 11" Above grd.

Sketch

TWP 26S R2W
1/4
S27 | 1981
PLS 1706

Monument Set (Procedures and Description)

New Accessories

11" Hemlock bear's N87°W - 40 1/2 FT Scribed
"S27 1/4 B.T." (1987)

9" Hemlock Bear's S70°30'W - 42 1/2 FT Scribed
"S27 1/4 B.T." (1987)

Location & Comments

Surveyor's Seal

Compass Declination 19°E


Firm/Agency CHAMPION
International

Address P.O. Box 1328
Roseburg OR

Party Chief LYNN Sibley

Notes DEAN TURNER

Witness _____

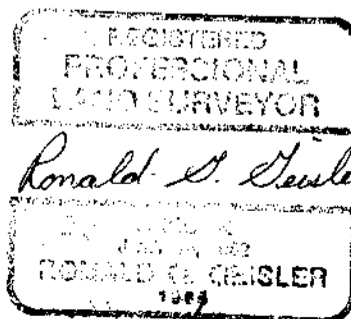

C.S. File No. 63/60-4

#140 x

C