

FILED TF

OREGON CORNER RESTORATION FORM

JUL 15 1987

Section 36 Township 26S Range 3W

COUNTY SURVEYOR
DOUGLAS COUNTY, ORE.

County Douglas Date 6-30-87

Corner Designation

N.E. Sec Cor

- Condition Report Only
- Not Found
- Renewed
- Unrecorded
- Surveyed In
- Referenced Out

Previous Renewals/Surveys, etc. Ren #123 T26-3


Monument(s) & Accessories Found: (Condition and Source)

9" D. FIR Bear's S37°W - 7 $\frac{1}{2}$ FT Healed Face (1966)
9" D. FIR Bear's N5°W - 16 $\frac{1}{2}$ FT Healed Face (1966)
36" D. FIR Bear's N45°W - 21 $\frac{1}{2}$ FT - CHOPPED FACE -
BRAG MARK'S VISIBLE (ORIGINAL)
8" D. FIR NOW down & uprooted Bear's N61°E -
4 $\frac{1}{2}$ FT (1966)

Monument Detail

2 $\frac{1}{2}$ " B.C. on a 1" I.P.
extends 12" above grd.

Sketch

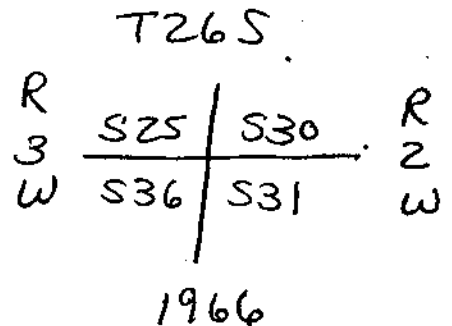

Monument Set (Procedures and Description)


New Accessories

5" D. FIR Bear's N74°E - 23 $\frac{3}{4}$ FT
scribed "T26S-R2W-S30-B.T." (1987)

Location & Comments

Compass Declination 19°E
 Firm/Agency CHAMPION
INTERNATIONAL
 Address P.O. Box 1328
Roseburg OR
 Party Chief Lynn Sibley
 Notes DEAN TURNER
 Witness _____

Surveyor's Seal

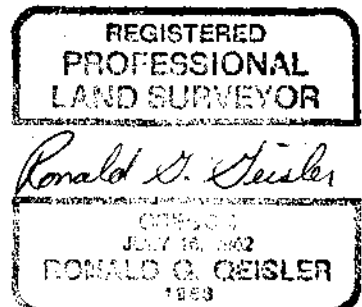

#247 T26-3 X
#139-T26-2 X

C.S. File No. 63/60-5c