

FILED TP

OREGON CORNER RESTORATION FORM

JUL 15 1987

Section 22/27 Township 29S Range 8W

COUNTY SURVEYOR  
DOUGLAS COUNTY, ORE.

County Douglas Date 6-30-87

Corner Designation

1/4

- Condition Report Only
- Not Found
- Renewed
- Unrecorded
- Surveyed In
- Referenced Out

Previous Renewals/Surveys, etc. Reit 86

Monument(s) & Accessories Found: (Condition and Source)

14" Cedar bear's S20°E - 72 FT Healed FACE (1958)  
6" D. FIR bear's N7°E - 14 FT - is uprooted, shattered  
and out of position (1958)  
34" FIR (Now Stump) Bear's N77°W - 48 FT - Lower  
BLAZE partially visible (original)

Monument Detail

Sketch

2 1/2" B.C. on a 1 1/2" I.P.  
extends 12" Above ground:

1/4 S22  
1/4 S27  
T29S R8W  
1958

Monument Set (Procedures and Description)

New Accessories

6" D. FIR bear's N54°E - 25 FT AND scribed  
1/4 S22 BT (1987)

Location & Comments

Surveyor's Seal

Compass Declination 19°E



Firm/Agency CHAMPION  
INTERNATIONAL

Address P.O. Box 1328  
Roseburg OR

Party Chief Don Turner

Notes Lynn Sibley

Witness \_\_\_\_\_

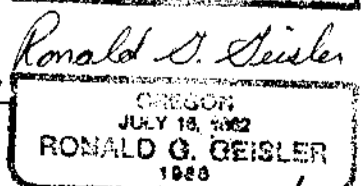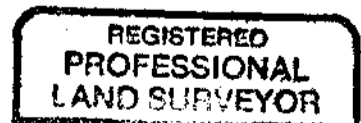

C.S. File No. 63/62-6 C

#2054