


CERTIFIED RECORD OF LAND CORNER MONUMENTATION

History of original corner establishment:

FILED TF

MAR 23 1988

COUNTY SURVEYOR
DOUGLAS COUNTY, ORE.

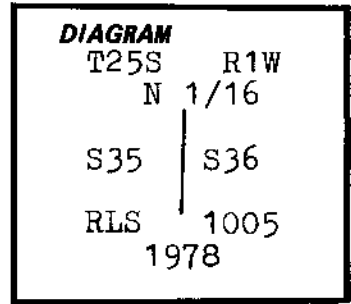

Description of corner evidence found:


A 2" galv. iron pipe with 2½" brass cap in small stone mound. Brass cap extends 4" above mound and is marked as shown in diagram, from which:

- A 9" Hemlock bears N83°E, 17.9 feet - vis. scribing.
- A 12" Hemlock stump bears S70°W, 32.0 feet- vis. scribing.

Description of monument and accessories I established to perpetuate the original location of this corner:

(new BT) A 7" Hemlock bears S6°W, 17.6 feet, scribed "N1/16 S35 RS1035 BT" with brasswasher stamped "RLS 1035" nailed flush to lower end of blaze.

I hereby certify the above corner was perpetuated as hereon described on Feb. 17, 1988. Bearing tree and monument signs were placed on all B.T.s without them and a 6" red band and face blazes were painted on all bearing trees.

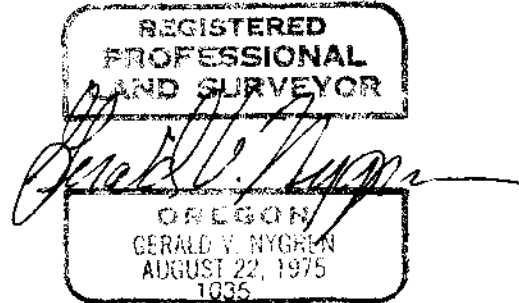

Office of... Surveyor..... County of... Douglas.....
 State of... Oregon....., I hereby certify that the within instrument was filed in this office
 for record on the 23... day of... March....., 19_88
 Fritz Ingram..... by *Jenni Franssen*.....
 (COUNTY OFFICIAL) (DEPUTY)

X

63/69-6