


CERTIFIED RECORD OF LAND CORNER MONUMENTATION

History of original corner establishment:

FILED TF

MAR 23 1988

**COUNTY SURVEYOR
DOUGLAS COUNTY, ORE.**

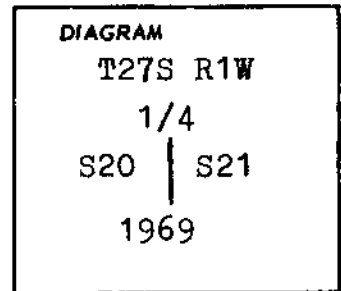

Description of corner evidence found:

Found 1" iron pipe with 2 1/2" brass cap extending 6" above ground and set by the Douglas County Surveyor, from which bears:

- A 30" Hemlock stump, N35°E, 30.5 feet. (vis. scar)
 - A 42" Fir stump, N54 1/2°W, 39.7 feet. (vis scribe)
 - A 14" Hemlock, S28 3/4°E, 69.1 feet. (vis. scribe)
- (distances are to center of trees)

Brass cap is marked as shown in diagram.

Description of monument and accessories I established to perpetuate the original location of this corner

New bearing tree:

A 8" D. Fir, S01°W, 32.6 feet, scribed "1/4 S20 BT" with A 1/2" brass washer marked "RLS 1035" nailed flush to lower end of blaze.

I hereby certify the above corner was perpetuated as hereon described on Feb. 12, 1988. Bearing tree signs and monument signs were placed on all bearing trees without them and a 6" red band and face blazes were painted on all bearing trees.

**REGISTERED
PROFESSIONAL
LAND SURVEYOR**

Gerald V. Nygren

OREGON
GERALD V. NYGREN
AUGUST 22, 1975
1035

Office of Surveyor County of Douglas

State of Oregon I hereby certify that the within instrument was filed in this office
for record on the 23 day of March, 1988, at 3:00 o'clock P.m., (signed)

Fritz Ingram by *Jesse Franzen*

(COUNTY OFFICIAL) (DEPUTY)