

CERTIFIED RECORD OF LAND CORNER MONUMENTATION


History of original corner establishment:

FILED

TF

MAR 23 1988

**COUNTY SURVEYOR
DOUGLAS COUNTY, ORE.**

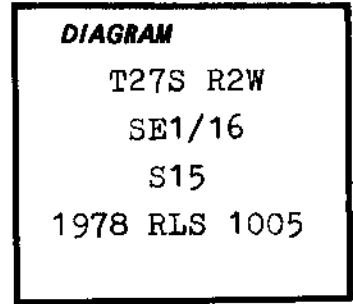

Description of corner evidence found:

Found 2½" Galv. iron pipe with 3" brass cap extended 4" above ground, on East edge of root wad. Brass cap is marked as shown in diagram, from which:

A 18" D. Fir, S44°W, 37.3 feet, scribing visible, this bearing tree was established by LS 1988 for Aluminum cap(previous survey).

A 12" D. Fir stump, S76°E, 17.2 feet. (healed blaze)

A 18" D. Fir, dead & down, S11°W, 18.8 feet.
(distances are to center of trees)

Aluminum cap set by RE 4287, S29°32'06"E, 6.24 feet.

Description of monument and accessories | established to perpetuate the original location of this corner:

New bearing tree:

A 18" D. Fir, South, 42.0 feet, scribed "SE1/16 S15 BT". A ½" brass washer marked "RLS 1035" was nailed flush to lower end of blaze.

I hereby certify the above corner was perpetuated as hereon described on Jan. 19, 1988. Bearing tree signs and monument signs were placed on all B.T.s without them and a 6" red band and face blazes were painted on all bearing trees.

**REGISTERED
PROFESSIONAL
LAND SURVEYOR**

Gerald V. Nygren

**OREGON
GERALD V. NYGREN
AUGUST 22, 1975
1035**

Office of.....Surveyors..... County of.....Douglas.....
State of.....Oregon....., I hereby certify that the within instrument was filed in this office
for record on the....23. day of.....March....., 1988.
.....Fritz Ingram..... by *Jesse Franssen*
(COUNTY OFFICIAL) (DEPUTY)

4