


CERTIFIED RECORD OF LAND CORNER MONUMENTATION

History of original corner establishment:

FILED TF

MAR 23 1988

**COUNTY SURVEYOR
DOUGLAS COUNTY, ORE.**

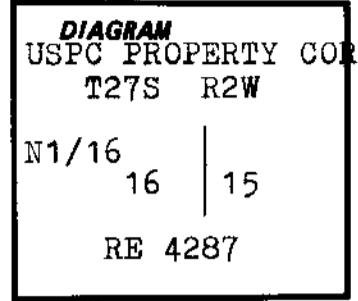

Description of corner evidence found:

A 3/4" iron pipe with a 2 1/2" alum. cap extending 12" above ground in small stone mound and marked as shown in diagram, from which:


- A 12" Maple bears N74 1/2° E, 25.3 feet - vis. scribing.
- A 12" Madrone bears S4° E, 22.2 feet - vis. scribing.

Description of monument and accessories established to perpetuate the original location of this corner:

(New BT) A 6" Maple bears S80° W, 31.0 feet, scribed "N1/16 S15 BT" with 1/2" brass washer stamped "RLS 1035" nailed flush to lower end of blaze.

I hereby certify the above corner was perpetuated as hereon described on Feb. 17, 1988. Bearing tree and monument signs were placed on all B.T.s without them and a 6" red band and face blazes were painted on all bearing trees.

**REGISTERED
PROFESSIONAL
LAND SURVEYOR**



**OREGON
GERALD V. NYGREN
AUGUST 22, 1975
1035**

Office of...SURVEYOR..... County of...Douglas.....
 State of...Oregon....., I hereby certify that the within instrument was filed in this office
 for record on the...23... day of...March....., 19...88
 ..Fritz Ingram..... by Jenni Franzen.....
 (COUNTY OFFICIAL) (DEPUTY)

X