


CERTIFIED RECORD OF LAND CORNER MONUMENTATION

History of original corner establishment:

FILED TF

MAR 23 1988

COUNTY SURVEYOR
DOUGLAS COUNTY, ORE.

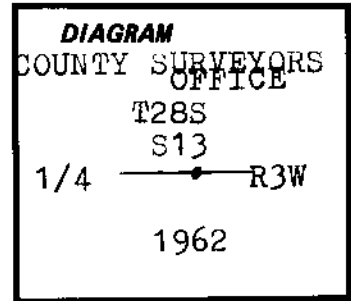

Description of corner evidence found:

A 1" galv. iron pipe with 2½" brass cap flush with ground marked as shown in diagram, from which:

A brass cap, 1/4 for sec. 24, N89°34'E, 12.24 feet.

An 8" Yew, N58°E, 6.1 ft. - vis. scibe.

A 14" Yew snag, S55½°W, 27.1 ft. - vis. scibe.

A 34" Hemlock stump, N84½°W, 11.0 ft. -vis. scibe.

Description of monument and accessories established to perpetuate the original location of this corner:

(New BT) A 13" Hemlock, N63°W, 35.8 ft., scribed "T28S R3W 1/4 S13 BT" with brass washer stamped "RLS 1035" nailed flush to the lower end of the blaze.

I hereby certify the above corner was perpetuated as hereon described on Feb. 17, 1988. Bearing tree and monument signs were placed on all BT's without them and a 6" red band and face blazes were painted on all bearing trees.

REGISTERED
PROFESSIONAL
LAND SURVEYOR

OREGON
GERALD V. NYGREN
AUGUST 22, 1975
1035

Office of... Surveyor..... County of... Douglas.....
State of... Oregon....., I hereby certify that the within instrument was filed in this office
for record on the... 23... day of... March....., 19... 88
Fritz Ingram..... by Juni Franzen.....
(COUNTY OFFICIAL) (DEPUTY)

REN # 161

C

63/69-12

X