


CERTIFIED RECORD OF LAND CORNER MONUMENTATION

History of original corner establishment:

FILED TF

MAR 23 1988

COUNTY SURVEYOR
DOUGLAS COUNTY, ORE.

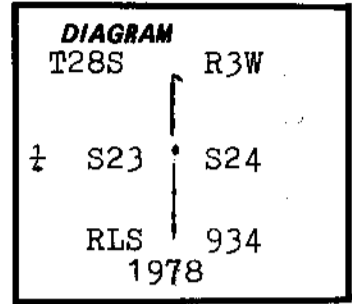

Description of corner evidence found:


A 2" galv. iron pipe with 3" brass cap extending 7" above ground and a 3/4" iron rod alongside. Brass cap is marked as shown in diagram, from which:

- A 14" Yew N82°E, 31.2 ft. (vis. scribing)
- A 14" Yew stump N47°W, 57.8 ft. (vis. scribing)
- A 56" fir stump N84°W, 15.5 ft.

Description of monument and accessories established to perpetuate the original location of this corner:

(new B.T.) A 5" D. Fir S30°W, 17.8 ft. - scribed "X" "BT". A 1/2" brass washer marked "RLS 1035" was nailed flush to the lower blaze.

I hereby certify the above corner was perpetuated as hereon described on Jan. 26, 1988. Bearing tree signs and monument signs were placed on all B.T.s without them and a 6" red band and face blazes were painted on all bearing trees.

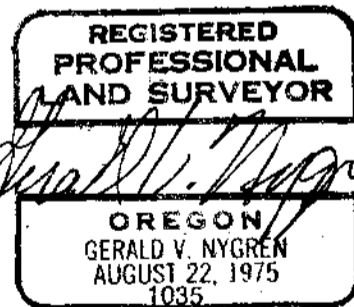

Office of...Surveyor..... County of...Douglas.....
 State of...Oregon....., I hereby certify that the within instrument was filed in this office
 for record on the...23 day of...March....., 19,88
 ..Fritz Ingram..... by Jesse Franzen
 (COUNTY OFFICIAL) (DEPUTY)

REN# 157 C

D.S. File No. 63/69-13

X