


CERTIFIED RECORD OF LAND CORNER MONUMENTATION

History of original corner establishment:

FILED TF

MAR 23 1988

**COUNTY SURVEYOR
DOUGLAS COUNTY, ORE.**

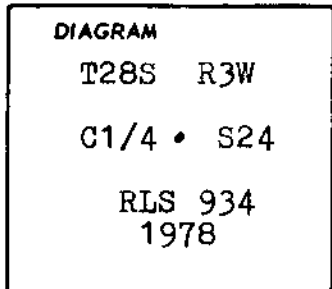

Description of corner evidence found:

A 2" galv. iron pipe with 3" brass cap ext. 4" above ground and marked as shown in corner diagram, from which:

An 8" Hemlock, dead and down, N44°E, 10.4 ft. - vis. scribing.

Description of monument and accessories I established to perpetuate the original location of this corner

(New BT's)

A 9" D. Fir, N2°W, 14.9 ft.

A 10" Hemlock, S48°W, 51.4 ft.

Both BT's scribed "C1/4 S24 BT" with a brass washer stamped "RLS 1035" nailed flush to the lower portion of the blaze.

I hereby certify the above corner was perpetuated as hereon described on Feb. 19, 1988. Bearing tree and monument signs were placed on all BT's without them and a 6" red band and face blazes were painted on all bearing trees.

**REGISTERED
PROFESSIONAL
LAND SURVEYOR**

**OREGON
GERALD V. NYGREN
AUGUST 22, 1975
1035**

Office of Surveyors..... County of Douglas.....
State of Oregon....., I hereby certify that the within instrument was filed in this office
for record on the 23 day of March....., 1988, at 3:00 o'clock P.m. (signed)
Eritz Ingram..... by Jesse Franzen
(COUNTY OFFICIAL) (DEPUTY)