


CERTIFIED RECORD OF LAND CORNER MONUMENTATION

History of original corner establishment:

FILED TF

MAR 23 1988

**COUNTY SURVEYOR
DOUGLAS COUNTY, ORE.**

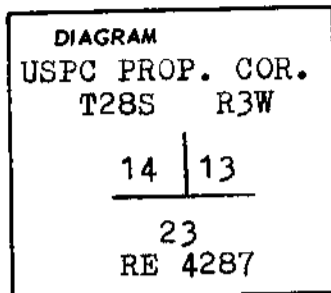

Description of corner evidence found:

- A 3/4" iron pipe with 2 1/2" alum. cap ext. 12" above ground and marked as shown in corner diagram, from which:
- A 9" D. Fir, N14°45'W, 46.2 ft. - blaze healed
- A 9" D. Fir, S62°W, 73.7 ft. - blaze healed
- An 18" Yew (dead), S12 1/2°E, 96.0 ft. - vis. scribe
- A 42" fir stump, N37°E, 32.8 ft.
- A 42" fir stump, N15 1/2°E, 32.6 ft. - Vis. scribe.
- A 36" rotted Hemlock stump, N67°W, 42.6 ft.

Description of monument and accessories established to perpetuate the original location of this corner

(New BT) A 6" D. Fir, N73°E, 38.0 ft., scribed "S13 T28S R3W BT" with brass washer stamped "RLS 1035" Nailed flush with the lower end of the blaze.

I hereby certify the above corner was perpetuated as hereon described on Feb. 19, 1988. Bearing tree and monument signs were placed on all BT's without them and a 6" red band and face blazes were painted on all bearing trees.



Office of Surveyors..... County of Douglas.....
 State of Oregon....., I hereby certify that the within instrument was filed in this office
 for record on the 23 day of March....., 1988, at 3:00 o'clock P.m., (signed)
 Fritz Ingram..... by Jesse Franzen
 (COUNTY OFFICIAL) (DEPUTY)