

CERTIFIED RECORD OF LAND CORNER MONUMENTATION


History of original corner establishment:

**FILED**

TF

**MAR 23 1988**

**COUNTY SURVEYOR  
DOUGLAS COUNTY, ORE.**

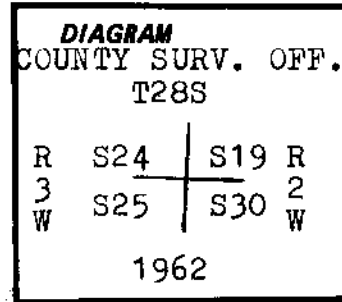

Description of corner evidence found:

A 1" iron pipe with 2½" brass cap ext. 14" above ground and marked as shown in corner diagram, from which:

An 18" Chinquapin Oak, S14½°W, 102.5 ft. - vis. scribe.

A 40" Hemlock stump, S14°E, 23.4 ft. - vis. scribe.

A 36" D. Fir stump, S29°W, 19.7 ft. - blaze healed.

A 36" D. Fir stump, N50°W, 15.8 ft. - vis. scribe.

Description of monument and accessories established to perpetuate the original location of this corner:

(New BT's)

An 8" Chinquapin Oak, S52°E, 45.0 ft., scribed "S30 T28S R2W BT".

A 5" Hemlock, N85°E, 43.3 ft., scribed "X" "BT".

A brass washer stamped "RLS 1035" was nailed flush with the lower portion of the blazes.

No tree available in the NW quadrant.

I hereby certify the above corner was perpetuated as hereon described on Feb. 17, 1988. Bearing tree and monument signs were placed on all BT's without them and a 6" red band and face blazes were painted on all bearing trees.

**REGISTERED  
PROFESSIONAL  
LAND SURVEYOR**

*Gerald V. Nygren*

**OREGON**  
GERALD V. NYGREN  
AUGUST 22, 1975  
1035

Office of... Surveyor..... County of... Douglas.....  
 State of... Oregon....., I hereby certify that the within instrument was filed in this office  
 for record on the... 23 day of... March....., 1988.  
 ... Fritz Ingram..... by *Jesse Franzen*.....  
 (COUNTY OFFICIAL) (DEPUTY)

Form R6-7100-57 (9/71)

☆ GPO—798-276

T28-3 REN #160  
T28-2 REN #144

S. File No. 63/69-16

X  
X