


CERTIFIED RECORD OF LAND CORNER MONUMENTATION

History of original corner establishment:

FILED TF

MAR 23 1988

**COUNTY SURVEYOR
DOUGLAS COUNTY, ORE.**

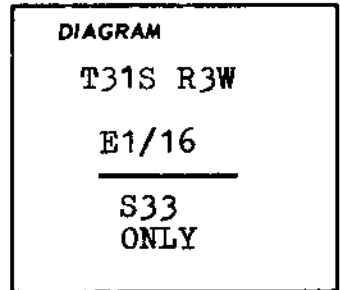

Description of corner evidence found:

Corner monument has been obliterated by road construction. The corner point was established from the following found bearing trees:

- A 16" D. Fir, N80°40'W, 32.7 feet. (blaze healed)
 - A 13" D. Fir, S86°30'W, 34.4 feet. (vis. scribe)
- (distances are to center of trees)

Description of monument and accessories established to perpetuate the original location of this corner

New bearing tree:

A 6" P. Pine, S76°E, 44.7 feet, scribed "X" in small upper blaze and "BT" in small lower blaze with A 1/2" brass washer marked "RLS 1035" nailed flush to lower blaze.

I hereby certify the above corner was perpetuated as hereon described on March 1, 1988. Bearing tree signs and monument signs were placed on all bearing trees without them and A 6" red band and face blazes were painted on all bearing trees.

**REGISTERED
PROFESSIONAL
LAND SURVEYOR**

**OREGON
GERALD V. NYGREN
AUGUST 22, 1975
1035**

Office of Surveyor..... County of Douglas.....
 State of Oregon....., I hereby certify that the within instrument was filed in this office
 for record on the 23 day of March....., 1988, at 3:00 o'clock P.m., (signed)
 Fritz Ingram..... by Jerry Franzen
 (COUNTY OFFICIAL) (DEPUTY)

X