

OREGON CORNER RESTORATION FORM

Section 28 Township 21S Range 11W

County Douglas Date 3/1/88

Corner Designation

Center $\frac{1}{4}$

FILED

MAR 3 1 1988

COUNTY SURVEYOR
DOUGLAS COUNTY, ORE.

- Condition Report Only
- Not Found
- Renewed
- Unrecorded
- Surveyed In
- Referenced Out

Previous Renewals/Surveys, etc.

As set by James Prochnow PLS 1305 for U.S.F.S.
C.S. 58/294

Monument(s) & Accessories Found: (Condition and Source)

Ed. 2" alum cap for C/4 and BT 12" Fir, S47°E, 20.0ft


Ed. 3" alum cap W.C. to C/4 S87°13'30"W 42.20ft from C/4
and 2 BTs 12" Fir S45°W, 4.8ft and 14" Fir, N58°W, 14.2ft

Ed. 3" alum cap ref. mon. to W.C. N75°29'24"E, 168.21ft from W.C.
other ref. mon. to C/4 by Prochnow I couldn't find

A landing is to be constructed which will destroy the C/4
and the W.C. monuments with the BTs so I set a new
reference monument for the C/4

Monument Detail

Sketch

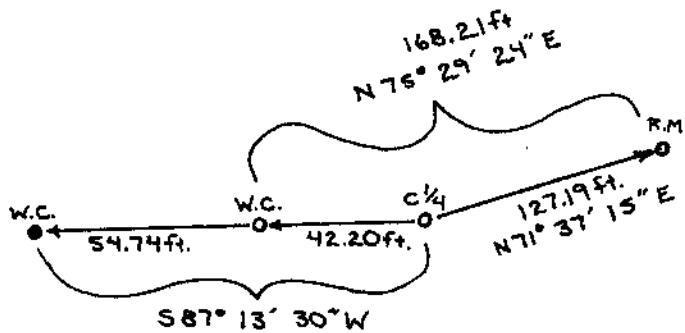

- o Found
- Set

Monument Set (Procedures and Description)

Set a 1/4" x 3/8" iron pipe with brass cap as marked above
and 2 bearing trees. Surveyed and set with a Pentax 10-D

12" D-fir, N69°W, 27.1ft. tagged and scribed "BT"

16" D-fir, N37°E, 2.6ft. tagged and scribed "BT"

bearings and distances measured to a spike in base of BTs

New Accessories

Location & Comments

I will be re-setting the Compass Declination _____
C/4 from the W.C. and Firm/Agency Menasha
the R.M. after the Land and Timber _____
logging is completed Address 1515 Sheridan

North Bend OR. 97459

Party Chief Mark Hoyer

Notes _____

Witness Pat Cook

Surveyor's Seal

REGISTERED
PROFESSIONAL
LAND SURVEYOR

Mark Hoyer

OREGON
JULY 13, 1984
MARK A. HOYE
2078

#226X

C.S. File No. 63/69-18