

FILED

MAR 31 1988

COUNTY SURVEYOR
DOUGLAS COUNTY, ORE.

OREGON CORNER RESTORATION FORM

Section 18 | 17 Township 22 S Range 5 W
19 | 20
County DOUGLAS Date 2/14/88

Corner Designation

18 | 17
19 | 20

- Condition Report Only
- Not Found
- Renewed
- Unrecorded
- Surveyed In
- Referenced Out


Previous Renewals/Surveys, etc. 1855 Harvey Gordon & Charles T. Gardner, G.L.O.; 1964 Wilford N. Haines, Reest. # 101.

Monument(s) & Accessories Found: (Condition and Source)

Found 3/4" x 48" T-iron, bent North, per Reest. #101, from which: A 30' low sawed fir stump bears S 69° 17' W 347.1' (record S 69 1/2° W 338.0' per Reest. #101).

Monument Detail

Sketch

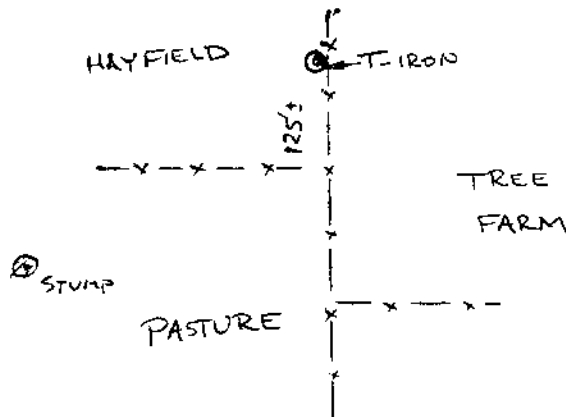

Monument Set (Procedures and Description)

NONE

New Accessories

NONE

Location & Comments

Bearings are turned from traverse with theodolite on solar basis.

Distances are horizontal to center of root crown measured with EDM.

Compass Declination N/A
Firm/Agency Cottage Grove Land Surveying
Address 76841 Hooton's Cor. Cottage Grove OR 97424
Party Chief Robert G. Dean
Notes Survey for Noel Hardie
Witness None

Surveyor's Seal

REGISTERED
PROFESSIONAL
LAND SURVEYOR

OREGON
JULY 13, 1979
ROBERT G. DEAN
1808