


CERTIFIED RECORD OF LAND CORNER MONUMENTATION

History of original corner establishment:

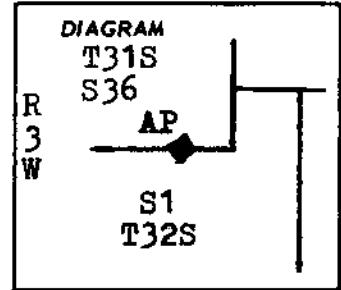

FILED *[Signature]*  
 MAY 5 1988  
 COUNTY SURVEYOR  
 DOUGLAS COUNTY, ORE.

Description of corner evidence found:

Found 46" Pine (angle point) line tree with USFS sign 52-2 attached.

Description of monument and accessories established to perpetuate the original location of this corner

New Bearing Trees:

A 13" D. Fir bears N78°W, 26.4 feet, scribed "T31S R3W S36 LINE TREE BT" with brass washer nailed to lower end of blaze.

A 7" D. Fir bears S24°E, 14.0 feet, scribed "S1 LINE TREE BT" with brass washer nailed to lower end of blaze.

I hereby certify the above corner point was perpetuated as hereon described on March 15, 1988. Bearing tree signs and monument signs were placed on all bearing trees and a 6" red band and face blazes were painted on all bearing trees.

REGISTERED  
 PROFESSIONAL  
 LAND SURVEYOR

*[Signature]*

OREGON  
 GERALD V. NYGREN  
 AUGUST 22, 1975  
 1035

Office of Surveyor ..... County of Douglas .....  
 State of Oregon ..... I hereby certify that the within instrument was filed in this office  
 for record on the 5 day of May ..... 1988, at ..... o'clock ..... m., (signed)  
 Fritz Ingram ..... by *[Signature]* .....  
 (COUNTY OFFICIAL) (DEPUTY)