


CERTIFIED RECORD OF LAND CORNER MONUMENTATION

History of original corner establishment:

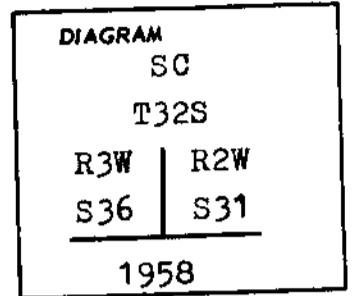

**FILED**  
*[Signature]*  
 MAY 5 1988  
**COUNTY SURVEYOR**  
**DOUGLAS COUNTY, ORE.**

Description of corner evidence found:

Found 2" iron pipe with 3" standard B.L.M. brass cap extending 6" above ground and marked as shown in diagram, from which:  
 A 50" D. Fir burned snag bears N25°E, 52.8 feet. (burned open blaze)  
 A 8" D. Fir burned snag bears N61°E, 9.9 feet. (visible scribe)  
 A 15" D. Fir bears N61°W, 7.3 feet. (blaze healed)

Description of monument and accessories established to perpetuate the original location of this corner

New Bearing Tree:

A 20" D. Fir bears N88½°E, 18.0 feet, scribed "T32S R2W S31 BT".  
 A ½" brass washer is nailed flush to lower end of blaze.

I hereby certify the above corner point was perpetuated as hereon described on April 21, 1988. Bearing tree signs and monument signs were placed on all bearing trees without them and a 6" red band and face blazes were painted on all bearing trees.

**REGISTERED  
 PROFESSIONAL  
 LAND SURVEYOR**  
*[Signature]*  
**OREGON**  
 GERALD V. NYGREN  
 AUGUST 22, 1975  
 1035

Office of Surveyor..... County of..... Douglas.....  
 Oregon  
 State of....., I hereby certify that the within instrument was filed in this office  
 for record on the 5 day of May....., 1988, at o'clock.....m., (signed)  
 Fritz Ingram..... by *[Signature]*  
 (COUNTY OFFICIAL) (DEPUTY)

x