


CERTIFIED RECORD OF LAND CORNER MONUMENTATION

History of original corner establishment:

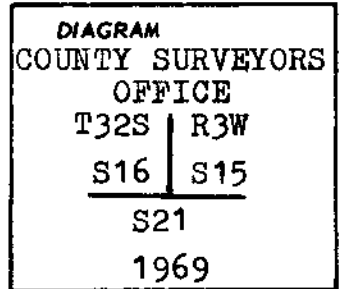

FILED *[Signature]*
MAY 5 1988
COUNTY SURVEYOR
DOUGLAS COUNTY, ORE

Description of corner evidence found:

Found 1" iron pipe with 2½" brass cap extended 10" above ground and marked as shown in diagram, from which:

- A 20" snag bears N64°W, 13.2 feet. (blaze healed)
- A 18" D. Fir stump bears N50°E, 9.2 feet. (blaze healed)
- A 20" D. Fir stump bears S37°W, 9.2 feet. (visible scribe)
- A 14" snag bears N02°30'E, 97.7 feet. (visible scribe)

Description of monument and accessories I established to perpetuate the original location of this corner

New Bearing Trees:

- A 6" D. Fir bears N53°W, 52.7 feet, scribed "X" in small upper blaze and "BT" in small lower blaze. A ½" brass washer in nailed flush to lower blaze.
- A 27" D. Fir bears N01°E, 107.2 feet, scribed "T32S R3W S15 BT" with brass washer nailed flush to lower end of blaze.

I herby certify the above corner point was perpetuated as hereon described on April 11, 1988. Bearing tree signs and monument signs were placed on all bearing trees without them and a 6" red band and face blazes were painted on all bearing trees.

REGISTERED
PROFESSIONAL
LAND SURVEYOR

[Signature]

OREGON
GERALD V. NYGREN
AUGUST 22, 1975
1035

Office of Surveyor County of Douglas
State of Oregon....., I hereby certify that the within instrument was filed in this office
for record on the 5 day of May....., 1988, at o'clock.....m., (signed)
Fritz Ingram by *[Signature]*
(COUNTY OFFICIAL) (DEPUTY)