


CERTIFIED RECORD OF LAND CORNER MONUMENTATION

History of original corner establishment:

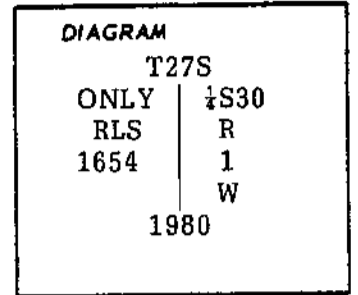

FILED

JK

NOV 30 1988

COUNTY SURVEYOR
DOUGLAS COUNTY, ORE.

Description of corner evidence found:

A 2 1/2" iron pipe with brass cap marked as shown in diagram, from which:

An 8" cedar bears S64°W, 15.8 feet - visible scribing.

An 8" hemlock bears N9°W, 17.8 feet - visible scribing.

A 16" hemlock stump bears S44°E, 19.9 feet - visible scribing.

*See #196 T27-2
#100 T27-1*

Description of monument and accessories established to perpetuate the original location of this corner

(New BT) A 7" cedar bears S25°E, 14.9 feet, scribed "1/4 S30BT".
Set 1/2" brass washer in BT face marked "LS 1035".

I hereby certify the above corner was perpetuated as hereon described on October 12, 1988. Bearing trees and monument signs were placed on all BT's without them and a 6" red band and face blazes were painted on all bearing trees.

REGISTERED
PROFESSIONAL
LAND SURVEYOR

Gerald V. Nygren

OREGON
GERALD V. NYGREN
AUGUST 22, 1975
1035

Office of Surveyor County of Douglas
State of Oregon, I hereby certify that the within instrument was filed in this office
for record on the 30 day of November 1988, at o'clock m., (signed)
Fritz Ingram by Virginia C. Rangan
(COUNTY OFFICIAL) (DEPUTY)

#250 T27-2 +
#196 T27-1 +
Form R6-7100-57 (9/66)

C.S. File No. 63/62-31