


CERTIFIED RECORD OF LAND CORNER MONUMENTATION

History of original corner establishment:

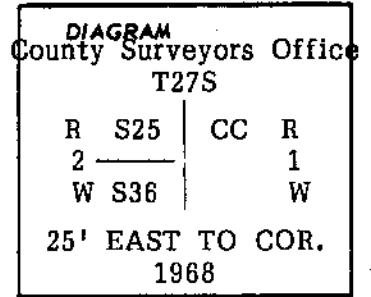

FILED

JK

NOV 30 1988

COUNTY SURVEYOR
DOUGLAS COUNTY, ORE.

Description of corner evidence found:

A 1½" iron pipe with brass cap extending 14" above ground. Brass cap is marked as shown in diagram, from which:

An 18" cedar bears N23°E, 12.0 feet - visible scribing.

A 20" hemlock, dead and down, bears S12°E, 40.0 feet.

*#10727
#10727*

Description of monument and accessories I established to perpetuate the original location of this corner

(New BT) 5' Douglas Fir bears S14°E, 30.7 feet, scribed "WC" on small upper blaze and "BT" on small lower blaze.

Set ½" brass washer in BT face marked "LS 1035".

I hereby certify the above corner was perpetuated as hereon described on October 13, 1988. Bearing tree and monument signs were placed on all BT's without them and a 6" red band and face blazes were painted on all bearing trees.

REGISTERED
PROFESSIONAL
LAND SURVEYOR

Gerald V. Nygren

OREGON
GERALD V. NYGREN
AUGUST 22, 1975
1035

Office of Surveyor..... County of Douglas
State of Oregon....., I hereby certify that the within instrument was filed in this office
for record on the 30 day of November, 19 88, at o'clock m., (signed)
.....Fritz Ingram..... by *Virginia A. Langer*.....
(COUNTY OFFICIAL) (DEPUTY)

#249 T.27-2 x
#197 T.27-1 x

Form R6-7100-57 (9/66)

C.S. File No. 63/69-32