



CERTIFIED RECORD OF LAND CORNER MONUMENTATION

History of original corner establishment:

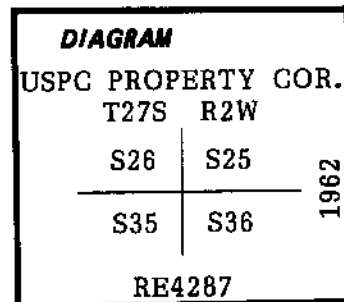

FILED


 NOV 30 1988

COUNTY SURVEYOR
 DOUGLAS COUNTY, ORE.

Description of corner evidence found:

A 1" iron pipe with a 2½" aluminum cap extended 6" above ground marked as shown in diagram, from which:

- A 27" fir stump bears S44°W, 6.4 ft. - visible scribing.
- A 24" fir stump, bears N18°E, 11.6 ft. - visible scribing.
- An 18" yewood bears S65½°E, 26.7 ft. - visible scribing.
- A 38" fir stump bears N60°W, 20.5 ft. - visible scribing.
- A metal post 1' north of corner.
- An 8" fir bears N88°W, 52.2 ft. - heal blazed.
- A 14" hemlock snag bears S4°E, 39.6 ft. - visible scribing.

Rec. # 205

*Rec. N4°W
 (PER NYGREN: S4°E IS CORRECT)
 NOV 1 1988*

Description of monument and accessories established to perpetuate the original location of this corner:

- (New BT) A 12" Douglas fir bears S34°W, 32.3 feet, scribed "T27S R2W S35 BT", and nailed brass washer in lower end of blaze.
- Set ½" brass washer in BT face marked "LS 1035".

I hereby certify that the above corner was perpetuated as hereon described on October 19, 1988. Bearing tree and monument signs were placed on all BT's without them and a 6" red band and face blazes were painted on all bearing trees.

REGISTERED
 PROFESSIONAL
 LAND SURVEYOR

 OREGON
 GERALD V. NYGREN
 AUGUST 22, 1975
 1035

Office of..... Surveyor..... County of... Douglas.....
 State of..... Oregon..... I hereby certify that the within instrument was filed in this office
 for record on the...30... day of... November..... 19..88
 Fritz Ingram by *Virginia C. Saugen*
 (COUNTY OFFICIAL) (DEPUTY)

Form R6-7100-57 (9/71)

#251 x

D.S. File No. *63/69-330*