


CERTIFIED RECORD OF LAND CORNER MONUMENTATION

History of original corner establishment:

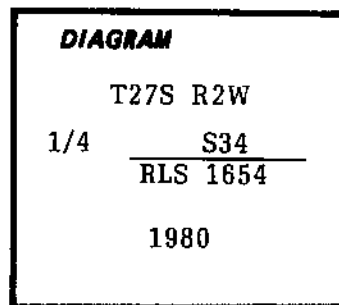

FILED *JL*
 NOV 30 1988
 COUNTY SURVEYOR
 DOUGLAS COUNTY, ORE.

Description of corner evidence found:

A 2 1/2" iron pipe with brass cap extended 8" above ground, marked as shown in diagram, from which:

- A 12" cedar snag bears N84°E, 19.9 feet - visible scribing.
- An 18" fir, dead and down, bears S30°W, 50.7 feet - visible scribing.
- Brass washers marked "RLS #1654" are set in BT faces.

196 T 27-2
 # 126 T 28-2

Description of monument and accessories I established to perpetuate the original location of this corner:

- (New BT's)
- A 10" yew bears S85°E, 81.7 feet, scribed "1/4 S34 BT".
- A 6" yew bears S40°W, 136.0 feet, scribed "1/4 S34 BT".
- Brass washer marked "LS 1035" and set in BT faces.

I hereby certify that the above corner was perpetuated as hereon described on October 14, 1988. Bearing tree and monument signs were placed on all BT's without them and a 6" red band and face blazes were painted on all bearing trees.

REGISTERED
 PROFESSIONAL
 LAND SURVEYOR

Gerald V. Nygren

OREGON
 GERALD V. NYGREN
 AUGUST 22, 1975
 1035

Office of.....Surveyor..... County of...Douglas.....
 State of.....Oregon....., I hereby certify that the within instrument was filed in this office
 for record on the.....30..... day of.....November....., 19.....88
Fritz Ingram..... byVirginia C. Laugen.....
 (COUNTY OFFICIAL) (DEPUTY)

#252 T. 27-2 ✓
 #148 T28-2 ✓