


CERTIFIED RECORD OF LAND CORNER MONUMENTATION

History of original corner establishment:

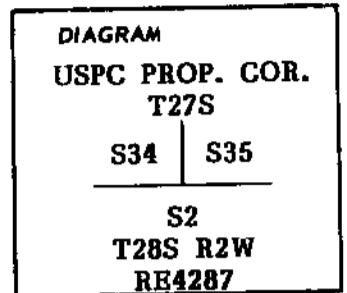

FILED

JK

NOV 30 1988

COUNTY SURVEYOR
DOUGLAS COUNTY, ORE.

Description of corner evidence found:

Corner location same as A-17.

An aluminum cap on a 3/4" iron rod, marked as shown in diagram, from which:

- A 16" fir stump bears N50°W, 22.7 feet,
- A 15" cedar snag bears S76°E, 6.6 feet,
- A 48" cedar stump bears S62°E, 25.6 feet - visible scribing,
- A 12" cedar bears N41°E, 58.1 feet - visible scribing,
- A 30" cedar stump bears N45°E, 7.3 feet,
- An 11" yew bears S76°E, 207.0 feet - visible scribing,
- An 11" hemlock snag bears N12°W, 184.0 feet - visible scribing.

#195 T27-2
#125 T28-2

Description of monument and accessories established to perpetuate the original location of this corner

- (New BT) A 7" yew bears N3°E, 39.2 feet, scribed "T27S R2W S35 BT"
- A 1/2" brass washer was set in BT face marked "LS 1035"

I hereby certify the above corner was perpetuated as hereon described on October 20, 1988. Bearing tree and monument signs were placed on all BT's without them and a 6" red band and face blazes were painted on all bearing trees.

REGISTERED
PROFESSIONAL
LAND SURVEYOR

Gerald V. Nygren

OREGON
GERALD V. NYGREN
AUGUST 22, 1975
1035

Office of Surveyor..... County of Douglas
 State of Oregon....., I hereby certify that the within instrument was filed in this office
 for record on the 30 day of November..... 1988, at..... o'clock..... m., (signed)
 Fritz Ingram..... by *Virginia C. Ransom*
 (COUNTY OFFICIAL) (DEPUTY)

#253 T.27-2 +
#147 T.28-2 +