


CERTIFIED RECORD OF LAND CORNER MONUMENTATION

History of original corner establishment:

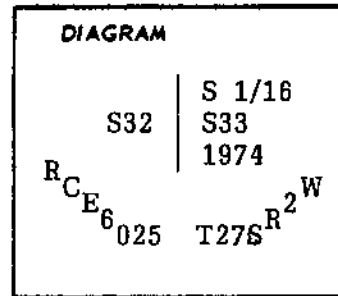

FILED

R

NOV 30 1988

COUNTY SURVEYOR
DOUGLAS COUNTY, ORE.

Description of corner evidence found:

A 2½" iron pipe with brass cap in stone mound marked as shown in diagram, from which:

A 16" hemlock bears N20°E, 34.4 feet - visible scribing.

A 13" hemlock snag bears S78°W, 20.7 feet - visible scribing.

Description of monument and accessories I established to perpetuate the original location of this corner

(New BT) An 8" hemlock bears S78°W, 8.8 feet, scribed "S 1/16 S32 BT"
Set ½" brass washer in BT face marked "LS 1035".

I hereby certify the above corner was perpetuated as hereon described on October 11, 1988. Bearing tree and monument signs were placed on all BT's without them and a 6" red band and face blazes were painted on all bearing trees.

REGISTERED
PROFESSIONAL
LAND SURVEYOR

Gerald V. Nygren

OREGON
GERALD V. NYGREN
AUGUST 22, 1975
1035

Office of Surveyor..... County of Douglas
State of Oregon....., I hereby certify that the within instrument was filed in this office
for record on the 30 day of November, 19 88, at..... o'clock a.m., (signed)
Fritz Ingram..... by Gerald V. Nygren
(COUNTY OFFICIAL) (DEPUTY)

X