


CERTIFIED RECORD OF LAND CORNER MONUMENTATION

History of original corner establishment:

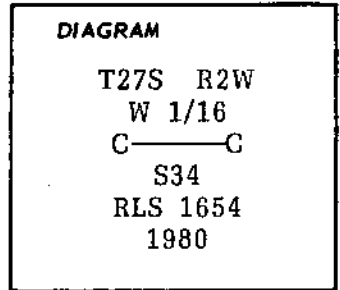

FILED
RB
 NOV 30 1988
 COUNTY SURVEYOR
 DOUGLAS COUNTY, ORE

Description of corner evidence found:

A 2½" iron pipe with brass cap marked as shown in diagram, from which:
June 1980 bearing trees are destroyed.

Description of monument and accessories I established to perpetuate the original location of this corner

(New BT's) A 12" hemlock bears S82¼°W, 135.5 feet scribed "CW 1/16 S34 BT"
An 8" hemlock bears S4°E, 143.8 feet scribed "CW 1/16 S34 BT" and
A ½" brass washer marked "LS 1035" was set in BT faces.

I hereby certify the above corner was perpetuated as hereon described on October 21, 1988. Bearing tree and monument signs were placed on all BT's without them and a 6" red band and face blazes were painted on all bearing trees.

REGISTERED
 PROFESSIONAL
 LAND SURVEYOR

Gerald V. Nygren
 OREGON
 GERALD V. NYGREN
 AUGUST 22, 1975
 1035

Office of Surveyor County of Douglas
 State of Oregon , I hereby certify that the within instrument was filed in this office
 for record on the 30 day of November 1988, at o'clock m., (signed)
 Fritz Ingram by *Therese A. Hansen*
 (COUNTY OFFICIAL) (DEPUTY)

A