


CERTIFIED RECORD OF LAND CORNER MONUMENTATION

History of original corner establishment:

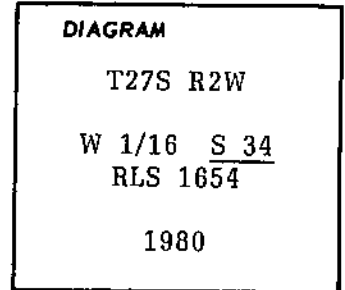

FILED

JK

NOV 30 1988

COUNTY SURVEYOR
DOUGLAS COUNTY, ORE

Description of corner evidence found:

A 2½" iron pipe with brass cap flush with ground, marked as shown in diagram, from which:

A 10' high, 22" hemlock snag bears N20°E, 43.7 feet - visible scribing,
A 16" yewood bears S52°E, 144.1 feet - visible scribing.

Description of monument and accessories established to perpetuate the original location of this corner

(New BT) A 5" D. fir bears S15°W, 24.4 feet, scribed "X BT".
Set ½" brass washer in BT face marked "LS 1035".

I hereby certify that the above corner was perpetuated as hereon described on October 21, 1988. Bearing tree and monument signs were placed on all BT's without them and a 6" red band and face blazes were painted on all bearing trees.

**REGISTERED
PROFESSIONAL
LAND SURVEYOR**

Gerald V. Nygren

**OREGON
GERALD V. NYGREN
AUGUST 22, 1975
1035**

Office of...SURVEYOR..... County of...Douglas.....
State of...Oregon....., I hereby certify that the within instrument was filed in this office
for record on the...30... day of...November....., 1988, at..... o'clock..... m., (signed)
Fritz Ingram by *Virginia A. Ferguson*
(COUNTY OFFICIAL) (DEPUTY)

4X